

Name Dryden M. Snow

Service No. 155

Address 241 East Street

Lot 22

Location

Kind of Pipe

Size

Size of Main

Repair—Renewal—**New Service** ✓ Valeri Const. # 241B

Location

APR 8 1974


Date	Material	Amount	Total	Date	Amount
Nov 170 14'	6" Transite Pipe @ 7.50		105.00	11-2-78	185.00
11-3-73	95' - 6" ACP				
	5' - 4" CI				
				11- - 70	
				14' 6" Transite	

DATE _____

TOWN OF LEXINGTON — BOARD OF PUBLIC WORKS

SEWER DIVISION

Sketch of Service Here **241**

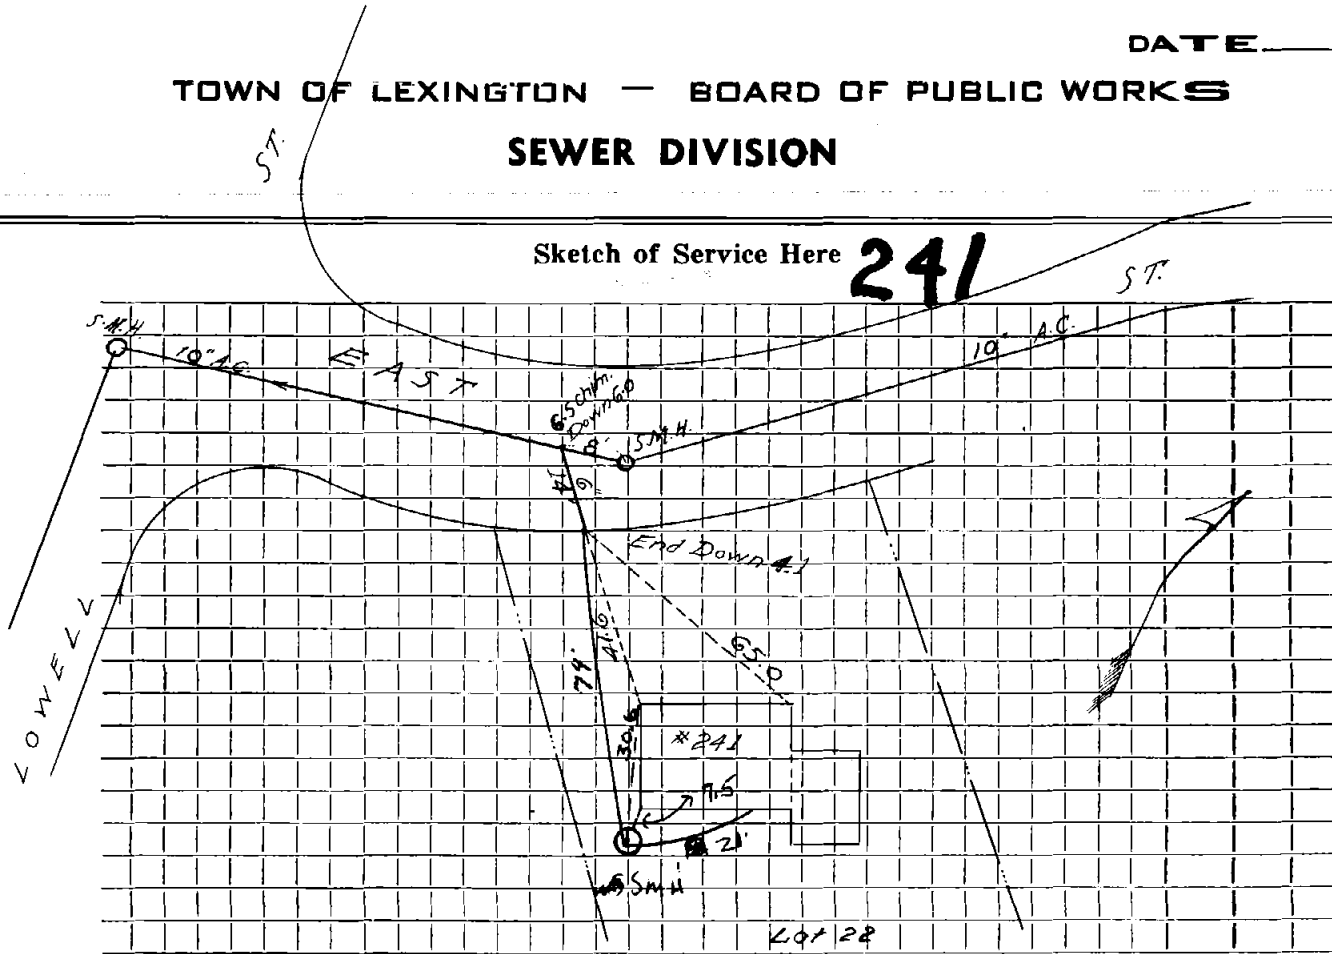

Connection made in Street. Work completed

Remarks:

.....