




DATE \_\_\_\_\_

TOWN OF LEXINGTON — BOARD OF PUBLIC WORKS

SEWER DIVISION

Sketch of Service Here **243**

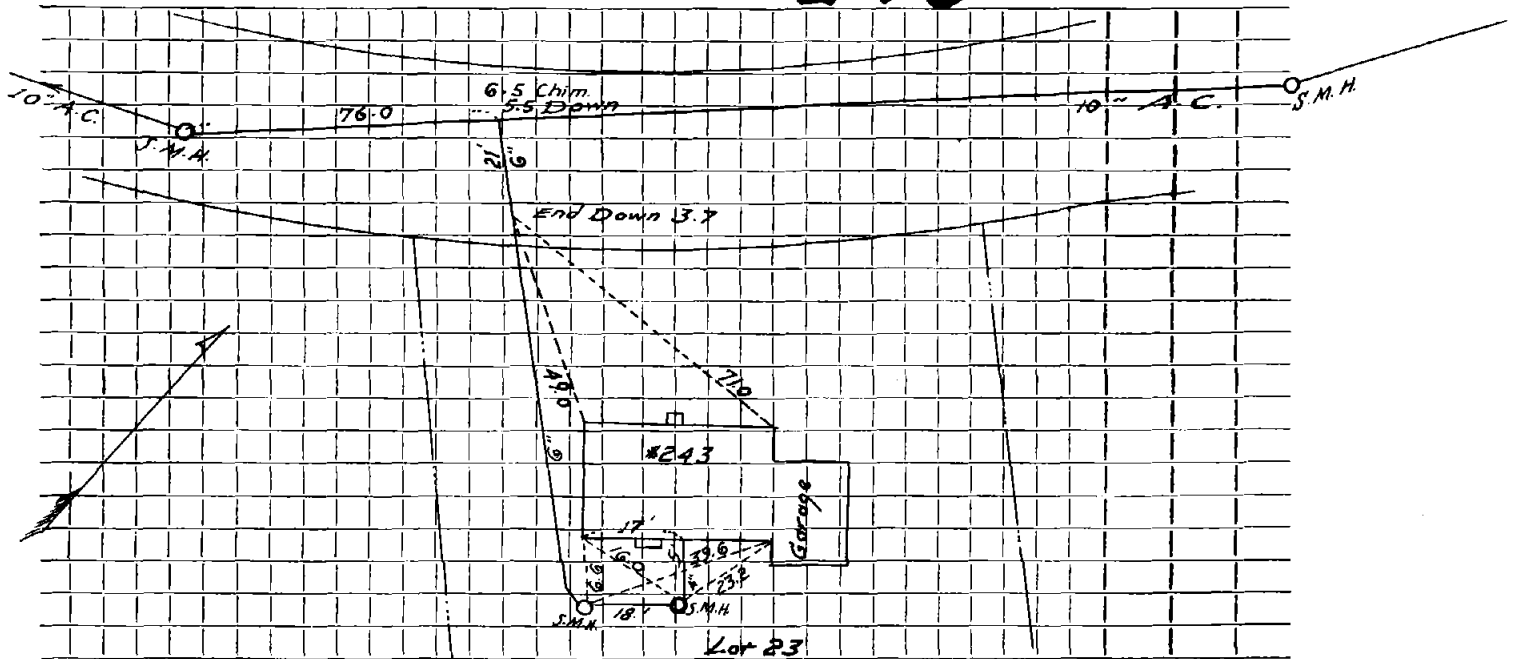

Connection made in ..... Street. Work completed .....

Remarks: .....

.....  
.....