

Name **Harold Jackson**

Service No. **87**

Address **247 East Street**

**Lot 1**

Location

Kind of Pipe

Size

Size of Main

Repair—Renewal—**New Service** Valeri #2741

Location **AUG 18 1976**


Date		Material		Amount	Total	Date		Amount
<del>9-1-70</del>	<del>24.6'</del>	<del>6"</del>	<del>Transite pipe</del>	<del>@7.50</del>	184.50	9-3-5	Deposit	184.50
8/8/75	130'	6"	Transite Pipe					
	23'	4"	Cast Iron Pipe					
						11- -70		
						24.6'	6" Transite	

DATE \_\_\_\_\_

TOWN OF LEXINGTON — BOARD OF PUBLIC WORKS

SEWER DIVISION

Sketch of Service Here **247**

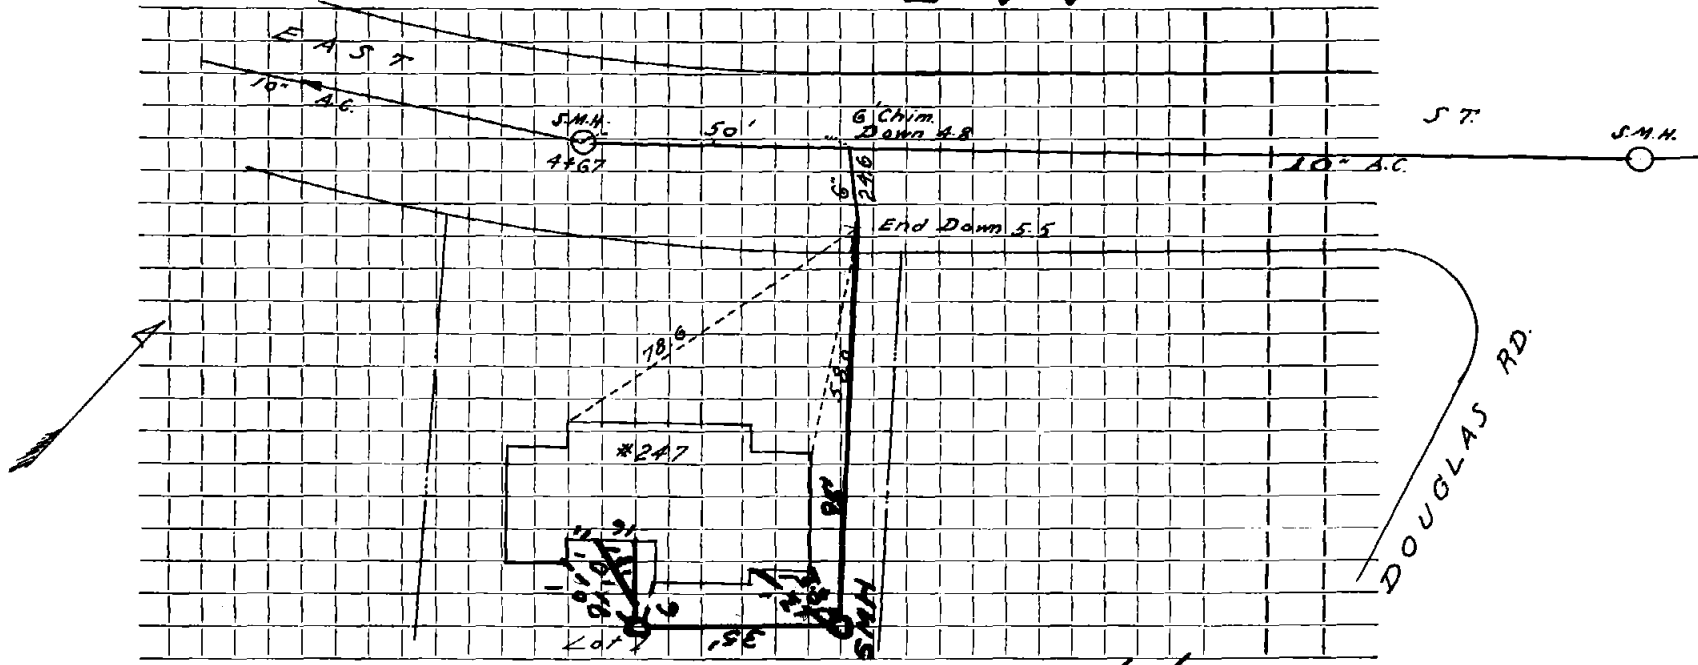

Connection made in 247 EAST ST. Street. Work completed 9/8/25

Remarks: .....

.....

.....