

Name Beatrice B. Baldwin

Service No. 15

Address 251 East Street

lot 2

Location lot 2

Kind of Pipe

Size

Size of Main


~~Repair~~ ~~Renewal~~ New Service

Location JUN 23 1980

Date	Material	Amount	Total	Date		Amount
5-21-70	6" Transite pipe @7.50		165.00	5-2-80	Deposit	165.00
				11- - 70	21' 6" Transite	

DATE _____

TOWN OF LEXINGTON — BOARD OF PUBLIC WORKS
SEWER DIVISION

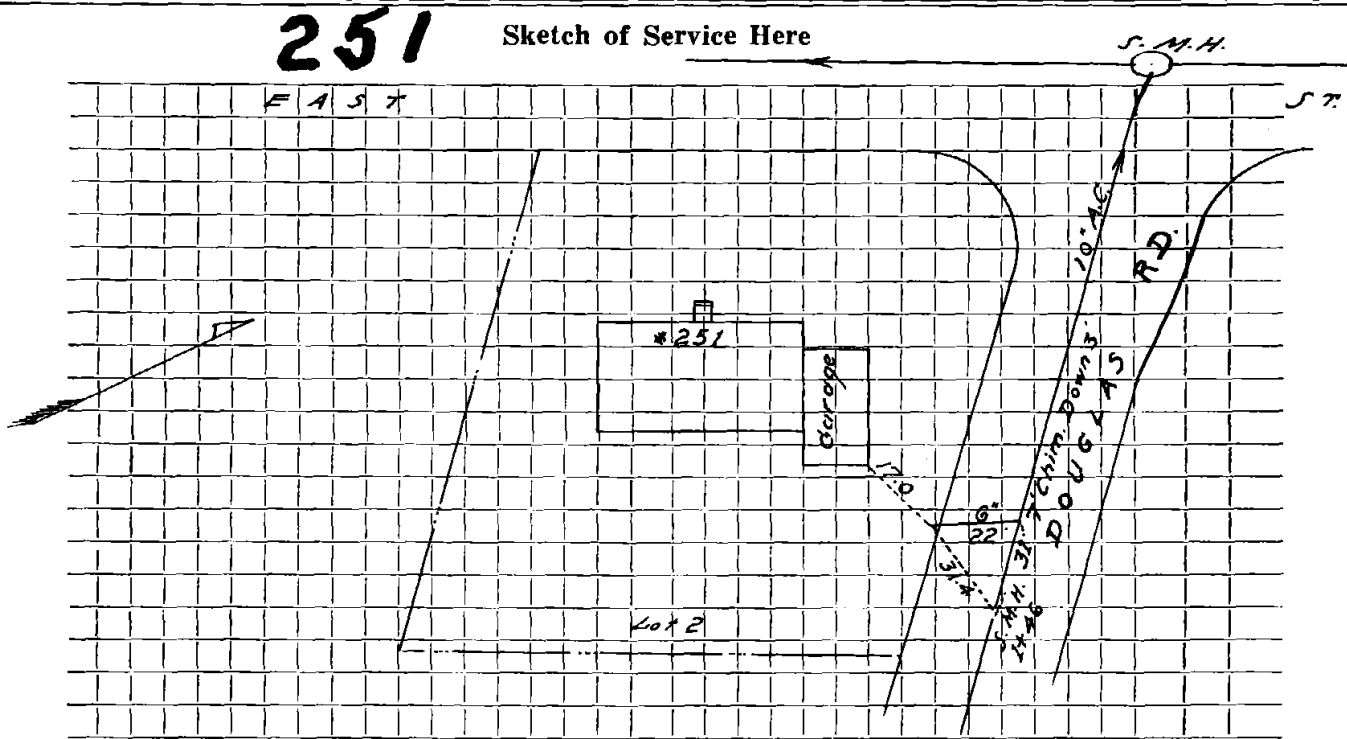

Connection made in Street. Work completed

Remarks:
.....
.....