

Name

Service No.

Address 254 EAST ST (TO BECOME 10 FOX RUN LN)

Location

Kind of Pipe

Size

Size of Main

Repair—Renewal—New Service NEW SERVICE - A. CARDILLO - SONS - #784

Location

Date

Material

Amount

Total

Date

Amount

6/6 96

3.5 LF 4" PVC

28 LF 6" PVC

6" x 6" FERNCO

4" x 6" FERNCO

11- -70


20' 6" Transite

DATE 6/6/96

TOWN OF LEXINGTON — BOARD OF PUBLIC WORKS
SEWER DIVISION

Sketch of Service Here

254

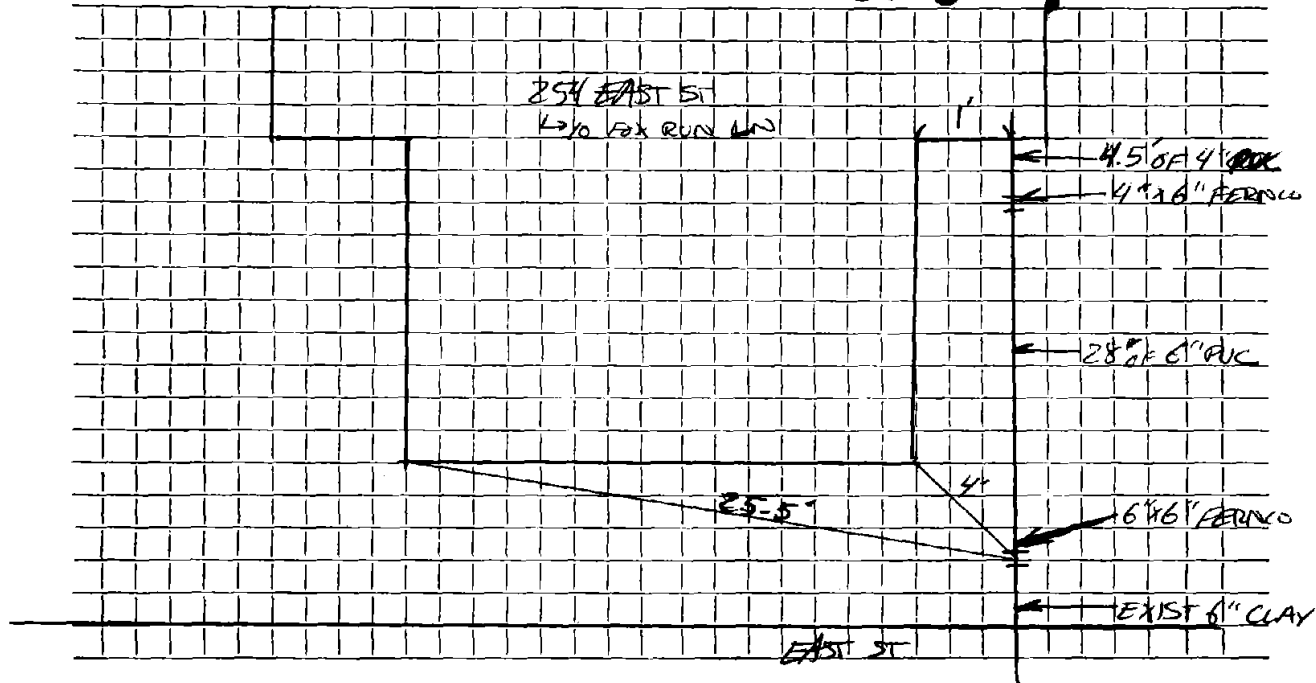

Connection made in Street. Work completed

Remarks:

.....
.....