


DATE 5/13/96

TOWN OF LEXINGTON — BOARD OF PUBLIC WORKS

SEWER DIVISION

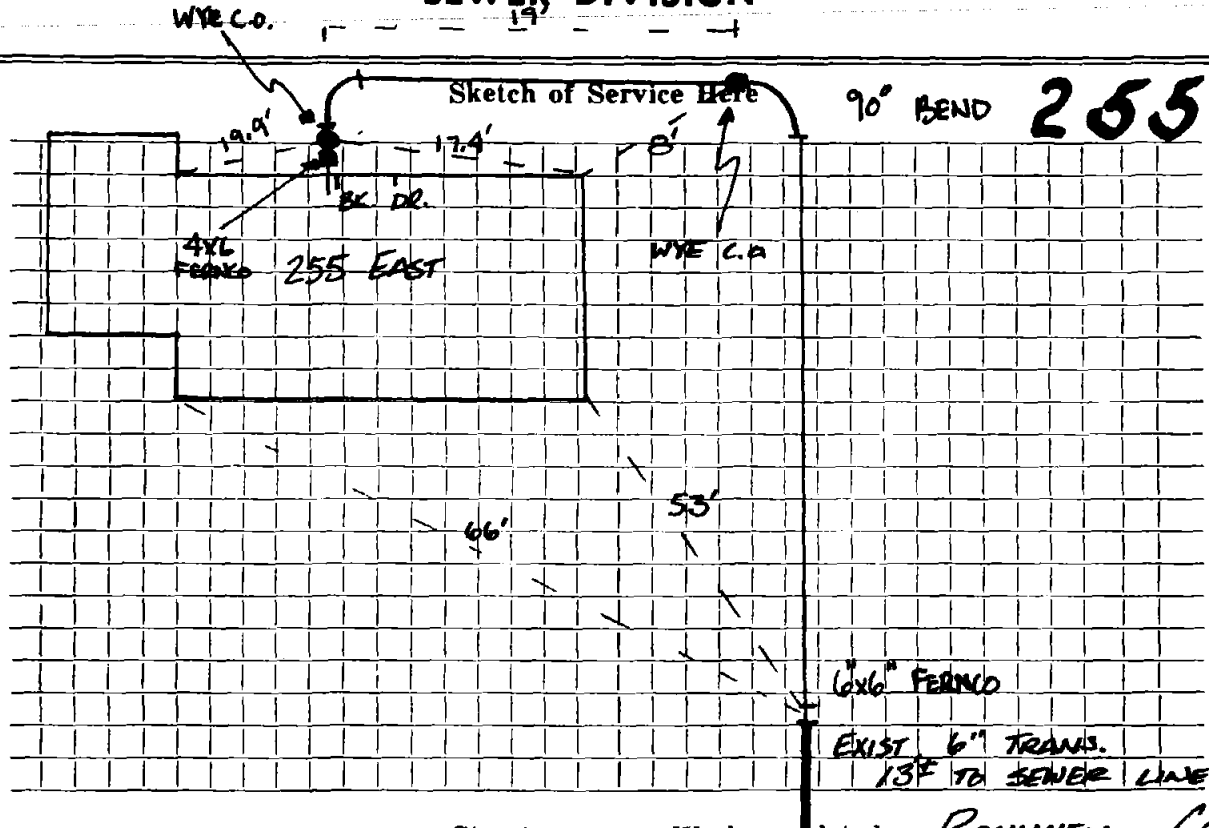

Connection made in Street.

Work completed ... ROCKWELL CONSTRUCTION

Remarks:
.....
.....