




DATE NOV-1970

TOWN OF LEXINGTON — BOARD OF PUBLIC WORKS

SEWER DIVISION

Sketch of Service Here

258

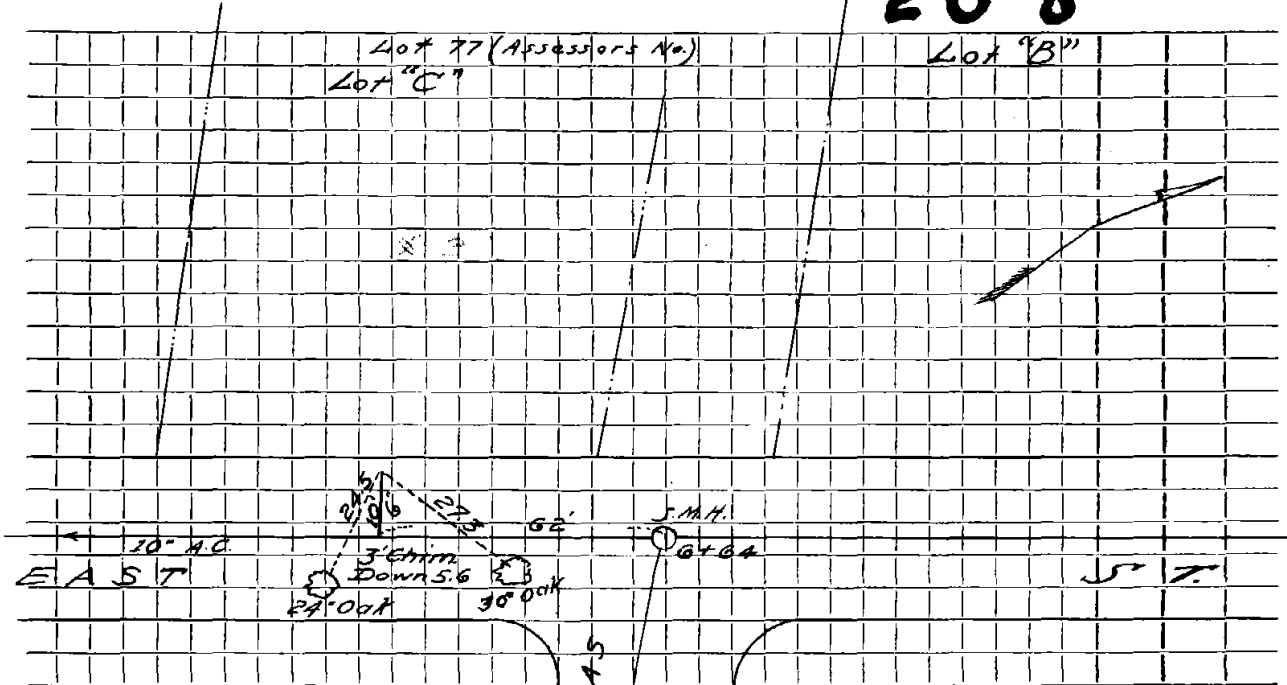


Connection made in EAST ST Street Work completed SEPT. 8, 1983

Remarks: .....

.....

.....

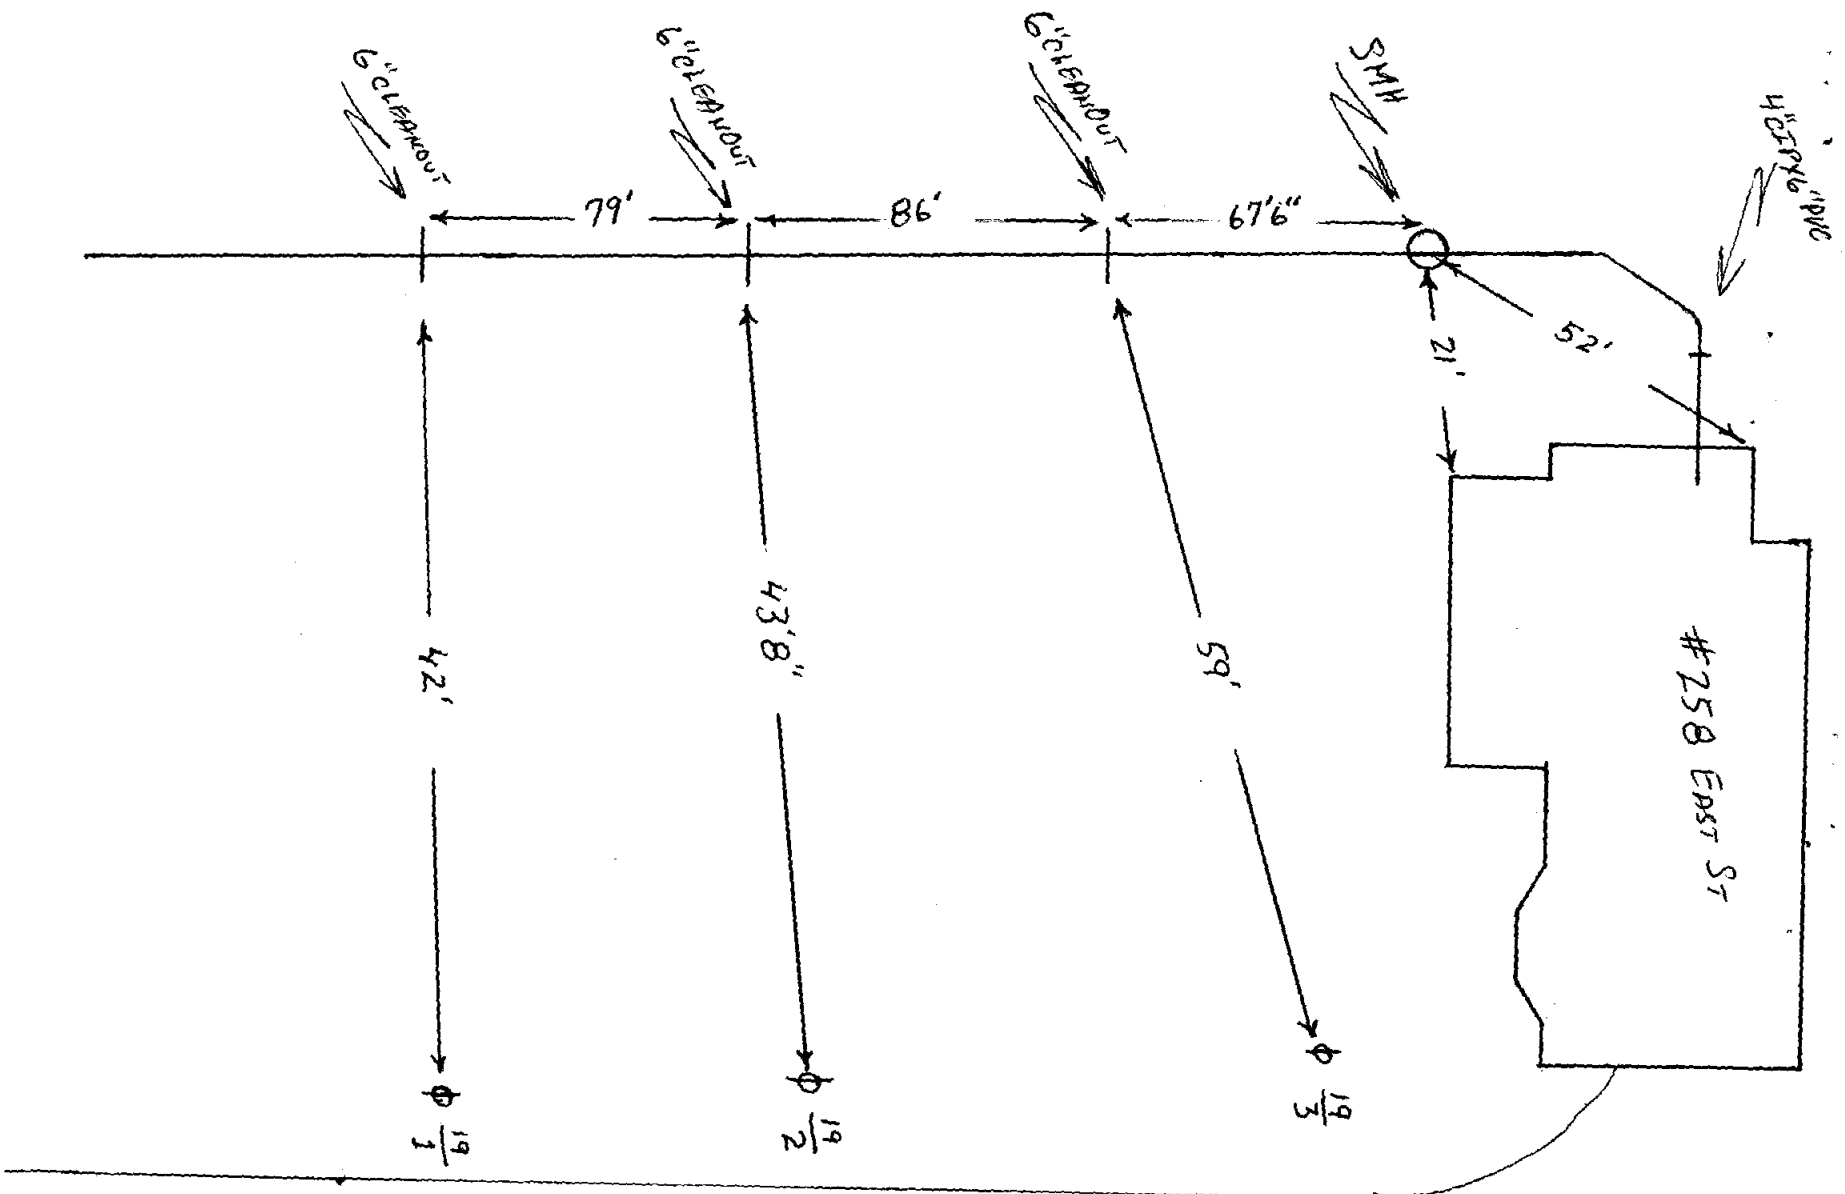

→ DRAINWAY →