

Name Robert Cowell

Service No. 72

Address 260 East Street

lot B

Location Lot "B"

Kind of Pipe

Size

Size of Main

~~Repair/Renewal~~ — New Service Craftsman, Inc. permit #2092

Location **AUG 14 1972**


Date	Material	Amount	Total	Date	Amount
<del>or 170</del>	<del>13' 6" Transite pipe @</del>	<del>7.50</del>	97.50	5-24-72	Deposit 97.50
6/27/72	95' 6" Transite			11- - 70	
	17' 4" Cast Iron			13' 6" Transite	

DATE \_\_\_\_\_

TOWN OF LEXINGTON — BOARD OF PUBLIC WORKS

SEWER DIVISION

**260** Sketch of Service Here

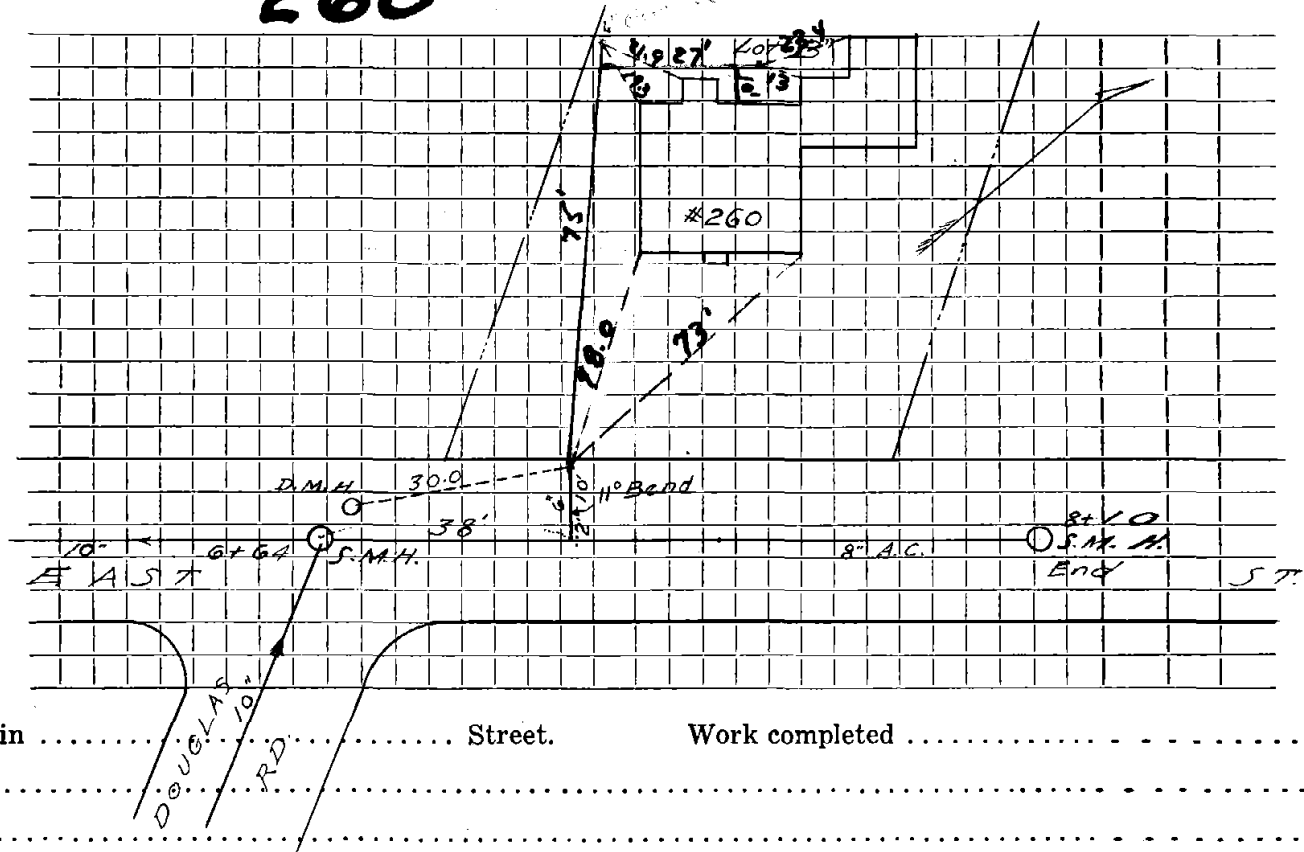

Connection made in ..... Street. Work completed .....

Remarks: .....  
.....  
.....