


DATE NOVEMBER 29, 1996

TOWN OF LEXINGTON — BOARD OF PUBLIC WORKS
SEWER DIVISION

Sketch of Service Here **262**

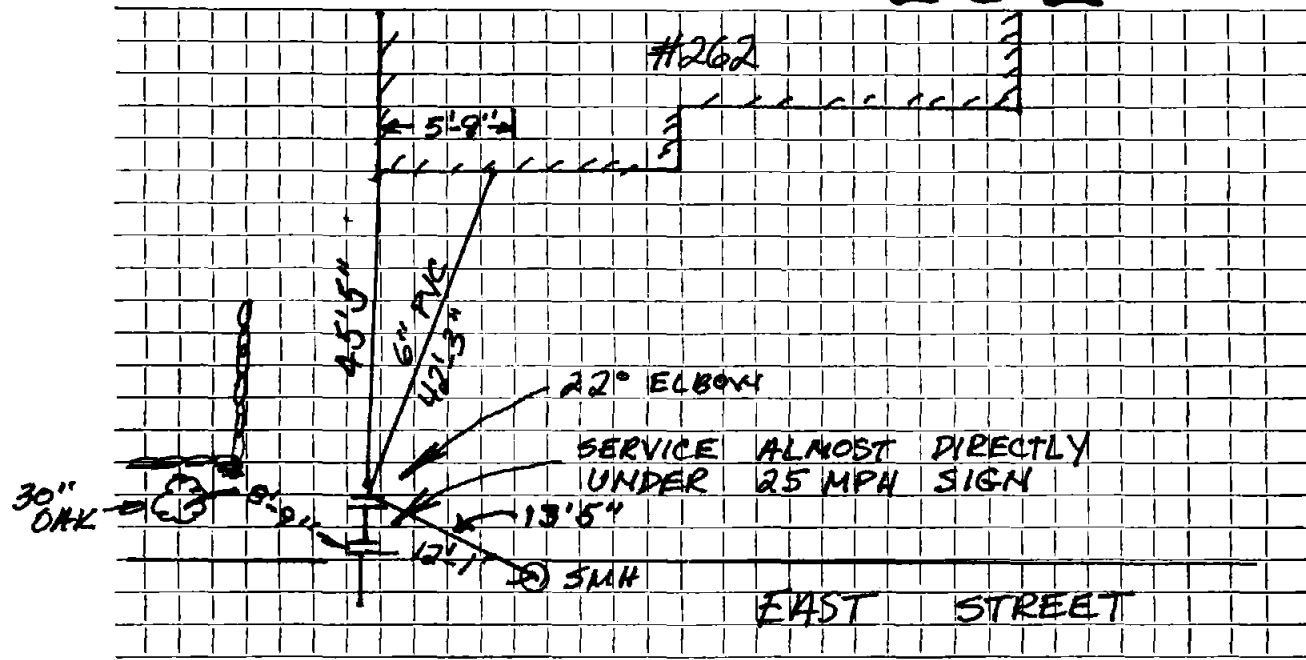

Connection made in EAST STREET Street. Work completed DAVID SANTO

Remarks: