

**Name**

**Service No.**

**Address** 32 East Street

Vacant lot

**Location**

**Kind of Pipe**

**Size**

**Size of Main**

**Repair—Renewal—New Service**

**Location**

Date

Material

Amount

Total

Date


Amount

DATE \_\_\_\_\_

TOWN OF LEXINGTON — BOARD OF PUBLIC WORKS

SEWER DIVISION

Sketch of Service Here

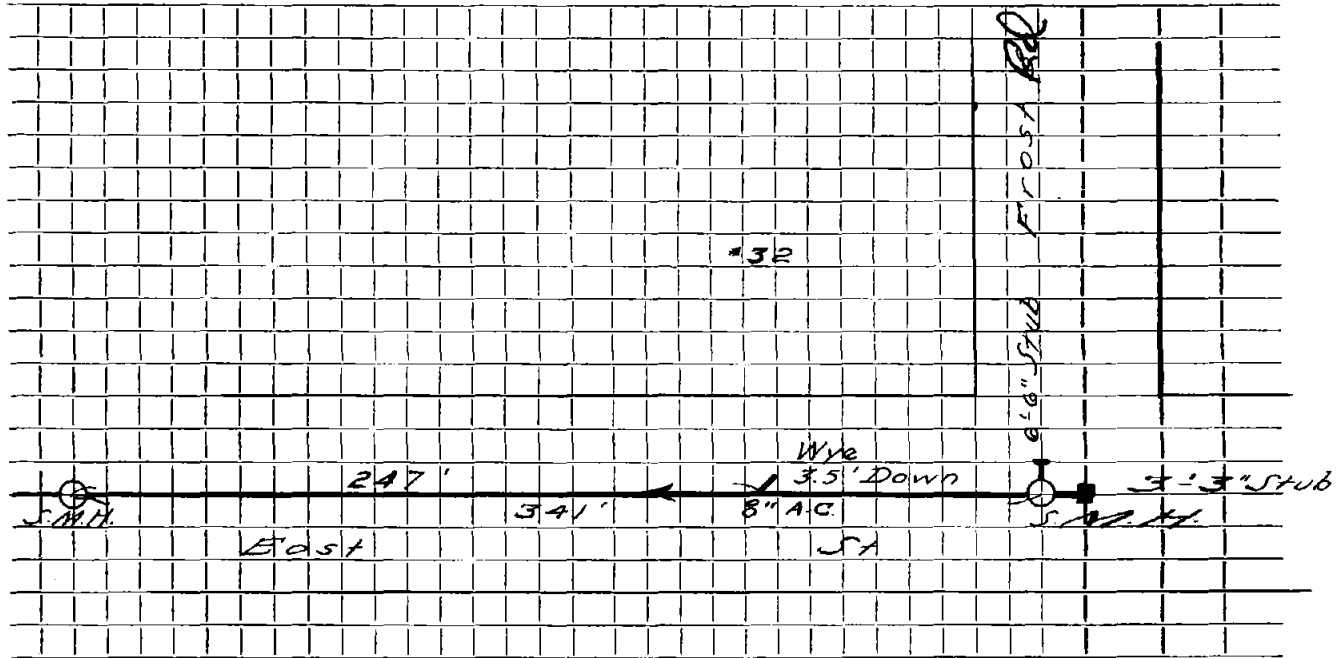

Connection made in ..... Street. Work completed .....

Remarks: .....

.....

.....