

Name

Service No.

Address

~~#~~ 33 EAST ST.

Location

Kind of Pipe

Size

6"

Size of Main

8"

Repair—Renewal—New Service

Location


Date	Material	Amount	Total	Date	Amount
<del>4/22/72</del>	<del>15.0' 6" A.C. @ \$9.00</del>	<del>\$135.00</del>		11-22-72	
				15' 6" A.C.	

DATE \_\_\_\_\_

# TOWN OF LEXINGTON — BOARD OF PUBLIC WORKS

## SEWER DIVISION

Sketch of Service Here

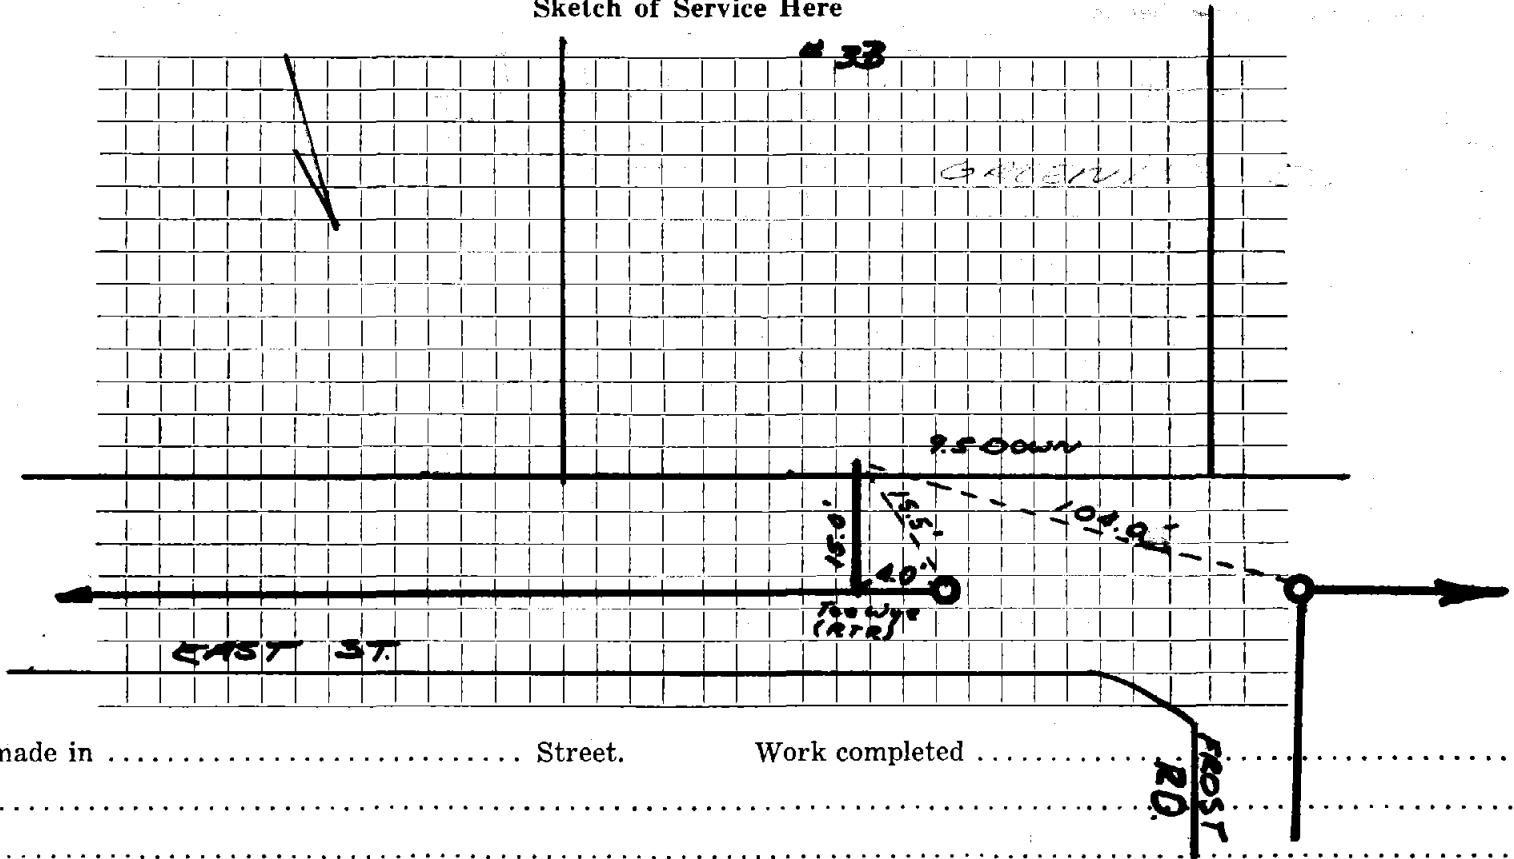

Connection made in ..... Street. Work completed .....

Remarks: .....  
.....  
.....