

Name

Service No.

Address #49 EAST ST.

Location

Kind of Pipe

Size

6" A.C.

Size of Main

8" A.C.

Repair—Renewal—New Service

Location

Date	Material	Amount	Total	Date	Amount
4/22/72	22.0' 6" A.C. @ \$9.00	\$ 207.00			
11/7 88	<del>XXXXXXXXXX</del> <del>XXXXXXXXXX</del> <del>XXXXXXXXXX</del> 12' 0" 6" PVC. ② 22' bands			11-22-72 23' 6" A.C.	


DATE \_\_\_\_\_

TOWN OF LEXINGTON — BOARD OF PUBLIC WORKS

SEWER DIVISION

Sketch of Service Here

49

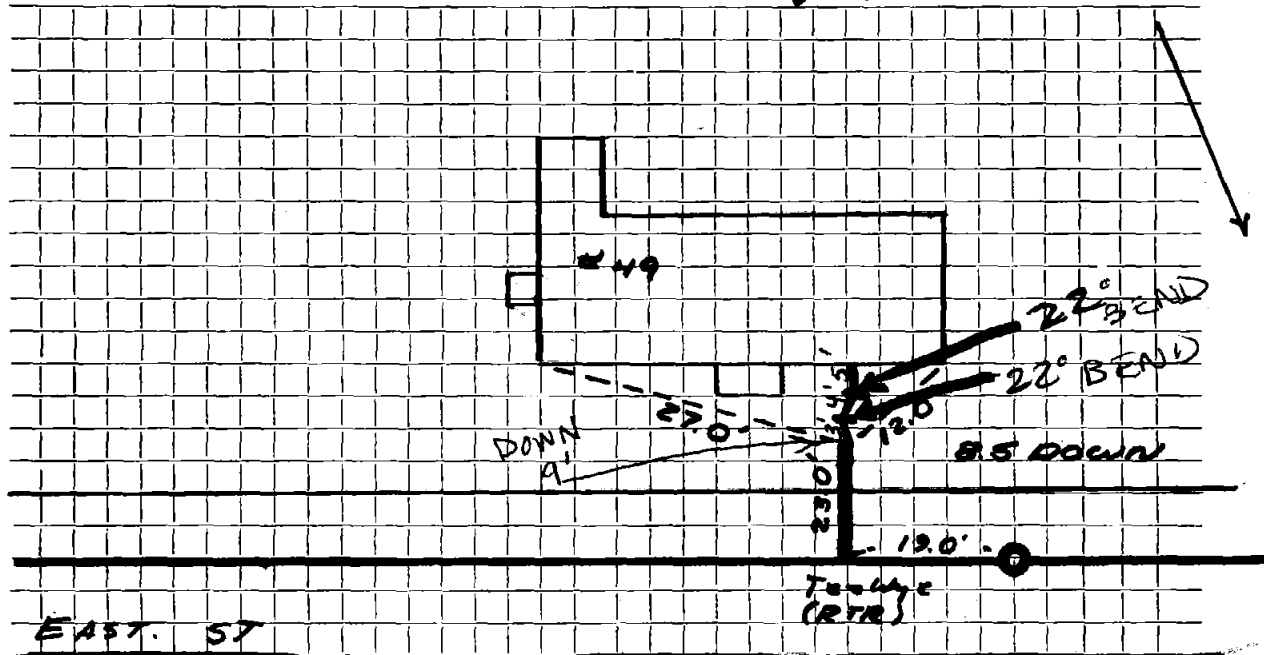

Connection made in ..... Street. Work completed .....

Remarks: .....

.....

.....