

Name

Service No.

Address #51 EAST ST.

Location

Kind of Pipe

Size

6" AC

Size of Main

8" AC

Repair—Renewal—New Service

Location


Date	Material	Amount	Total	Date	Amount
11/22/72	30.0' 6" AC @ \$9.00	\$270.00			
				11-22-72	
				30' 6" A.C.	

DATE \_\_\_\_\_

TOWN OF LEXINGTON — BOARD OF PUBLIC WORKS

SEWER DIVISION

Sketch of Service Here

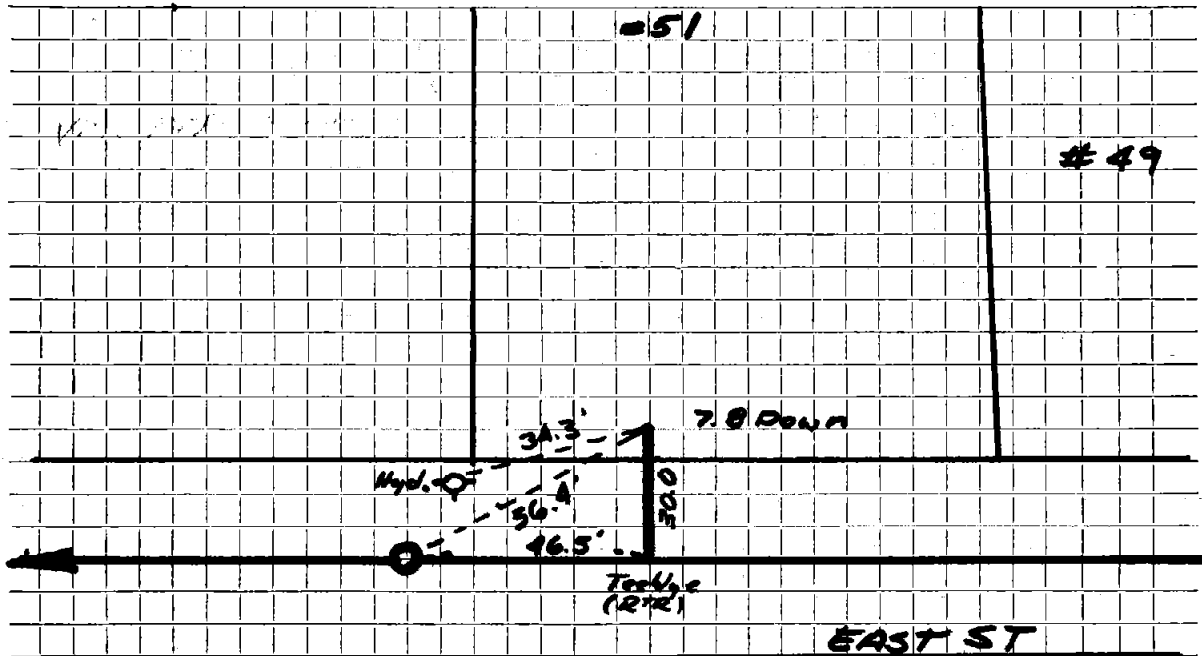

Connection made in ..... Street. Work completed .....

Remarks: .....

.....  
.....