

Name Paul R. Keeler

Service No. 78

Address # 71 EAST ST.

Location

Kind of Pipe

Size

6" A.C.

Size of Main 8" A.C.

Repair—Renewal—New Service

Valeri # 3183

Location

FEB 13 1978


Date	Material	Amount	Total	Date	Amount
11/22/77	33.0' 6" A.C. @ \$9.00	\$297.00		9-14-77	Deposit
9/16/77	87' 6" Transite Pipe				\$297.00
	10' 4" Cast Iron Pipe				
				11-22-72	
				33' 6" A.C.	

DATE _____

TOWN OF LEXINGTON — BOARD OF PUBLIC WORKS
SEWER DIVISION

Sketch of Service Here

71

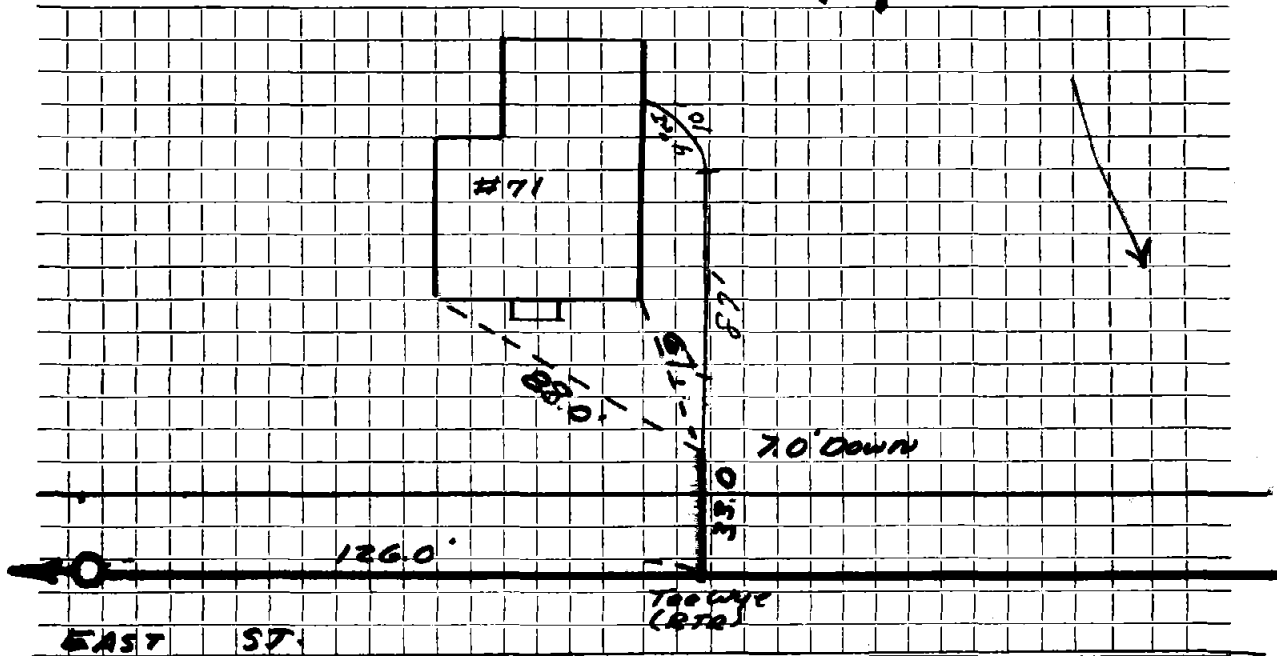

Connection made in Street. Work completed

Remarks:

.....
.....