

Name

Service No.

Address #76 EAST ST.

Location

Kind of Pipe

Size

6"

Size of Main

8"

Repair—Renewal—New Service

Location

Date

Material

Amount

Total

Date

Amount

~~11/21/72~~ 17.6 @ 9.00 \$153.60


11-21-72

17' 6" A.C.

DATE _____

TOWN OF LEXINGTON — BOARD OF PUBLIC WORKS

SEWER DIVISION

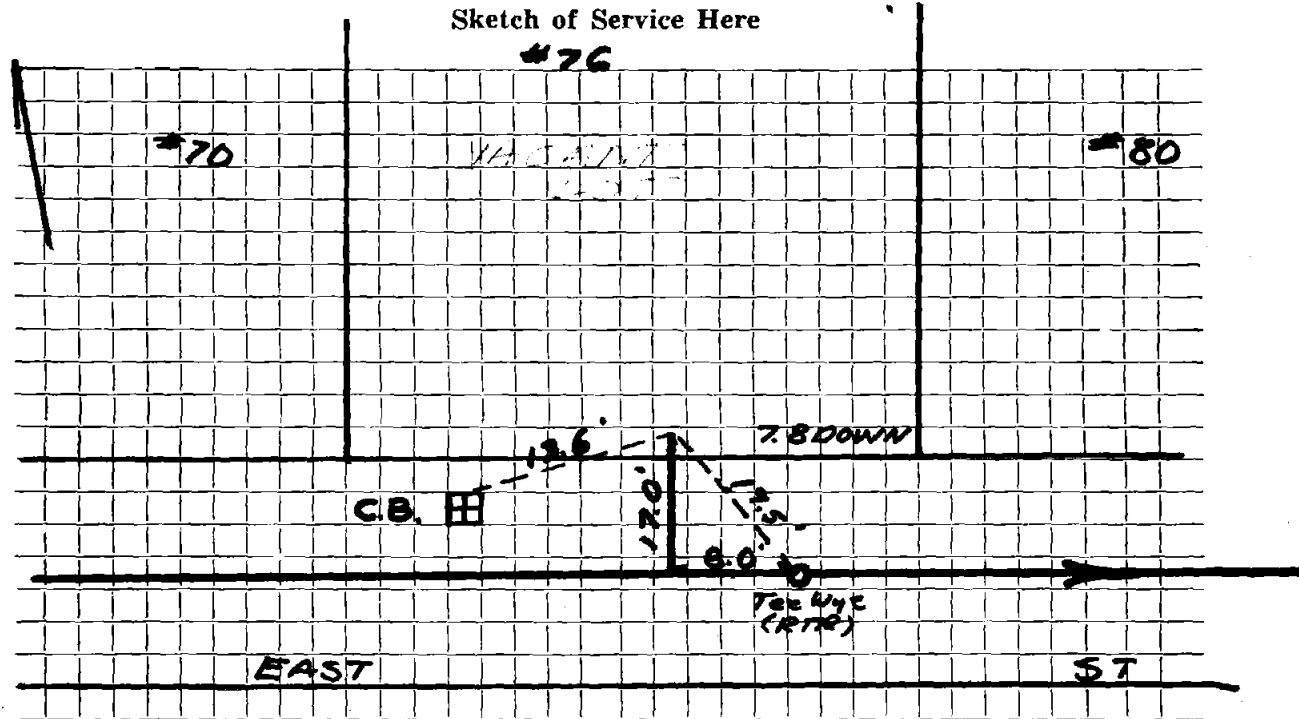

Connection made in Street. Work completed

Remarks:

.....
.....