

Name Paul R. Keeler, Jr.

Service No. 187

Address # 79 EAST ST.

Location

FEB 12 1973

Kind of Pipe

Size

6" A.C.

Size of Main

8" A.C.

Repair—Renewal—New Service

Trebino #2240

Location

Date

Material

Amount

Total

Date

Amount

4/24/72	340' C.A.C. @ \$9.00	\$306.00		12/5/72	Deposit	306.00
--------------------	---------------------------------	---------------------	--	---------	---------	--------

12/11/72 52' 6" Transite

10' 4" Cast Iron

11-22-72


34' 6" A.C.

DATE _____

TOWN OF LEXINGTON — BOARD OF PUBLIC WORKS

SEWER DIVISION

Sketch of Service Here **79**

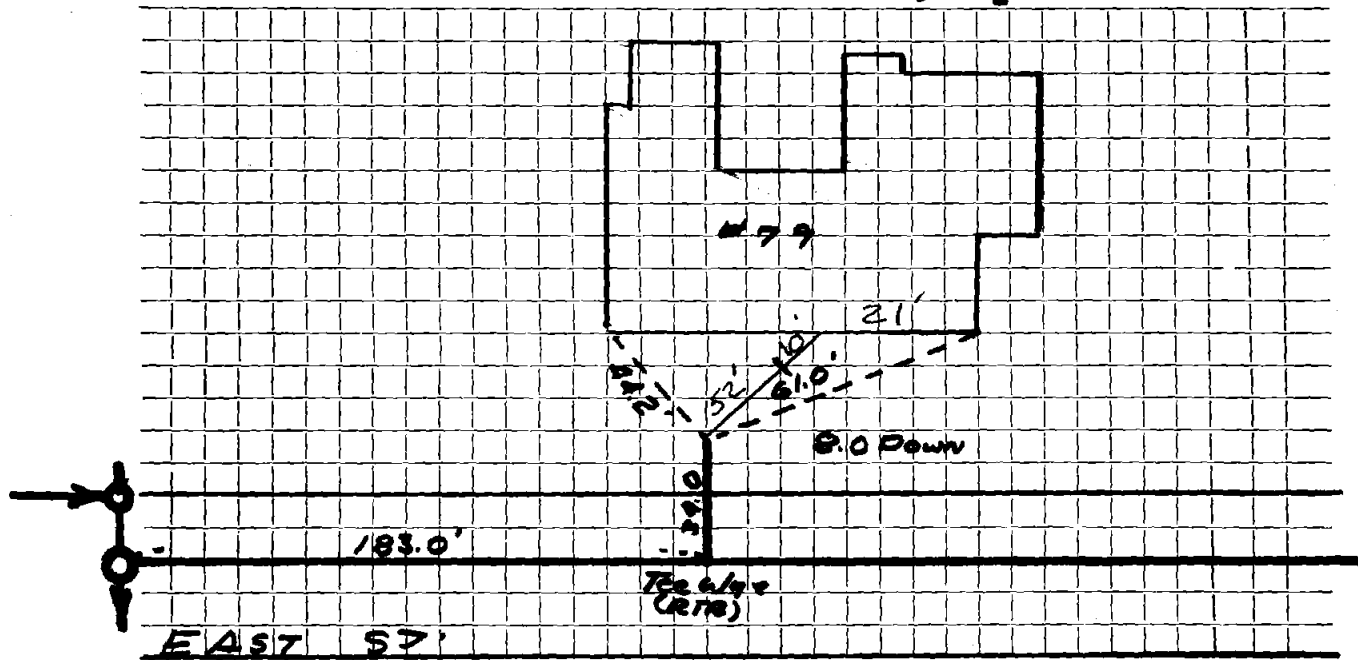

Connection made in Street. Work completed

Remarks:
.....
.....