

Name

Service No.

Address # 81 EAST ST.

Location

Kind of Pipe A.C.

Size 6"

Size of Main 6"

Repair—Renewal—New Service

Location

Date	Material	Amount	Total	Date		Amount
------	----------	--------	-------	------	--	--------

2/23/72	310 A.C. @ 9.00	\$279.00				
---------	-----------------	----------	--	--	--	--

2-23-72


31' 6" A.C.

DATE _____

TOWN OF LEXINGTON — BOARD OF PUBLIC WORKS

SEWER DIVISION

Sketch of Service Here

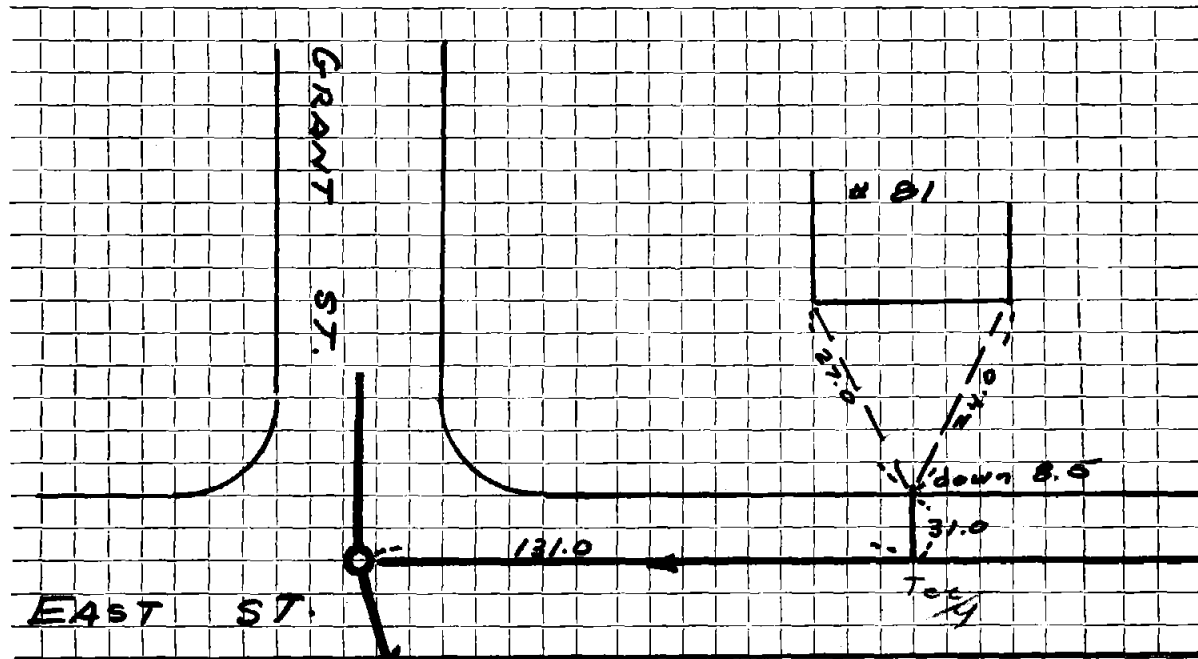

Connection made in Street. Work completed

Remarks:

.....

.....