

Name Elizabeth "O'Neill

Service No.

Address 86 EAST ST.

Location

Kind of Pipe PVC & CI

Size 4" & 6"

Size of Main

Repair—Renewal—New Service

Valeri #0062

Location


Date	Material	Amount	Total	Date	Amount
6/6/90	108 LF 6" PVC 5 LF 4" CI 3-WYE CLEANOUTS 2-6" 30° SWEEPS 6"-30° ELBOW 6"-45° ELBOW 4"x6" FERNCO 6"x6" FERNCO			5-30-90	paid 216.00
11/21/72	24' 6" A.C. @\$9.00		\$216.00		

DATE _____

TOWN OF LEXINGTON — BOARD OF PUBLIC WORKS

SEWER DIVISION

Sketch of Service Here **86**

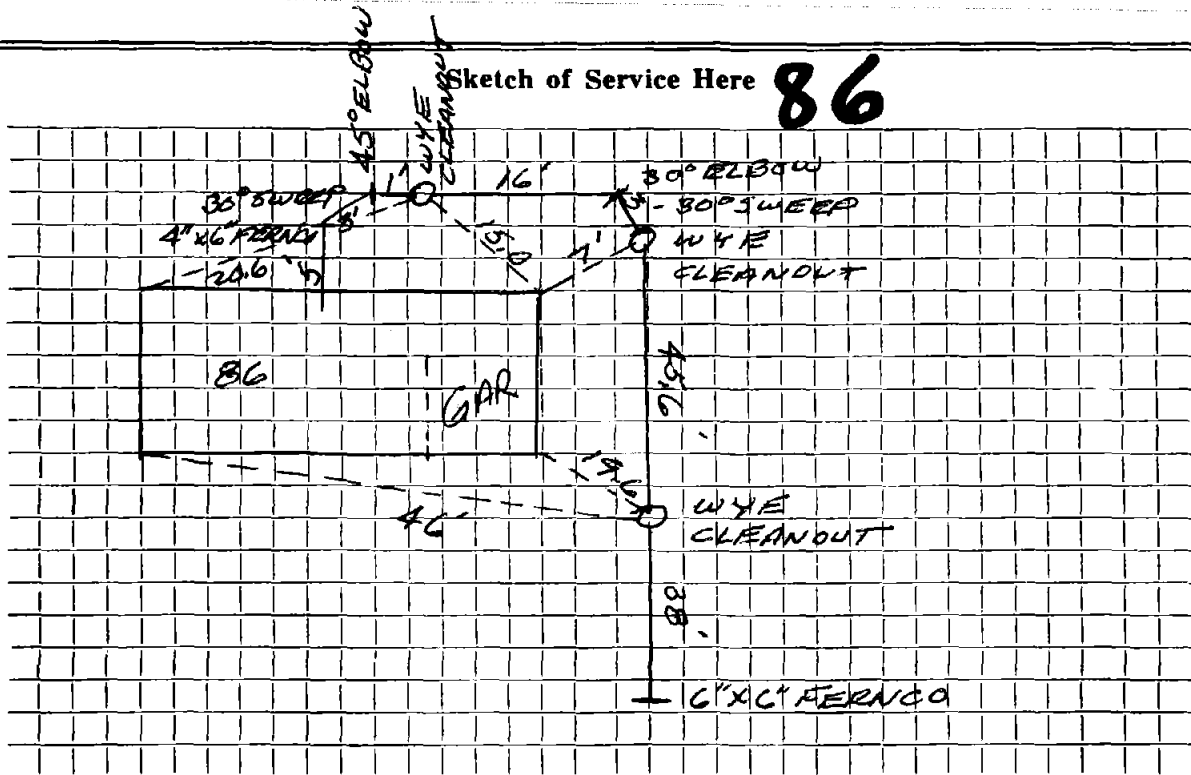

Connection made in EAST Street. Work completed

Remarks:

.....
.....