

Name Steven A. Moore

Service No.

1777  
22

Address #54 EAST ST.

Location

JUN 20 1977

Kind of Pipe

Size

6" A.C.

Size of Main

8" A.C.

Repair ~~Renewal~~ New Service

Eagle #3281

Location


Date	Material	Amount	Total	Date	Amount
<del>11/20/72</del>	<del>100' 6" A.C. @ \$9.00</del>	<del>\$90.00</del>		5/6/77	Deposit 90.00
5/14/77	75' 6" Transite Pipe				
	10' 4" Cast Iron				
				11-20-72	
				10' 6" A.C.	

DATE \_\_\_\_\_

TOWN OF LEXINGTON — BOARD OF PUBLIC WORKS

SEWER DIVISION

Sketch of Service Here **94**

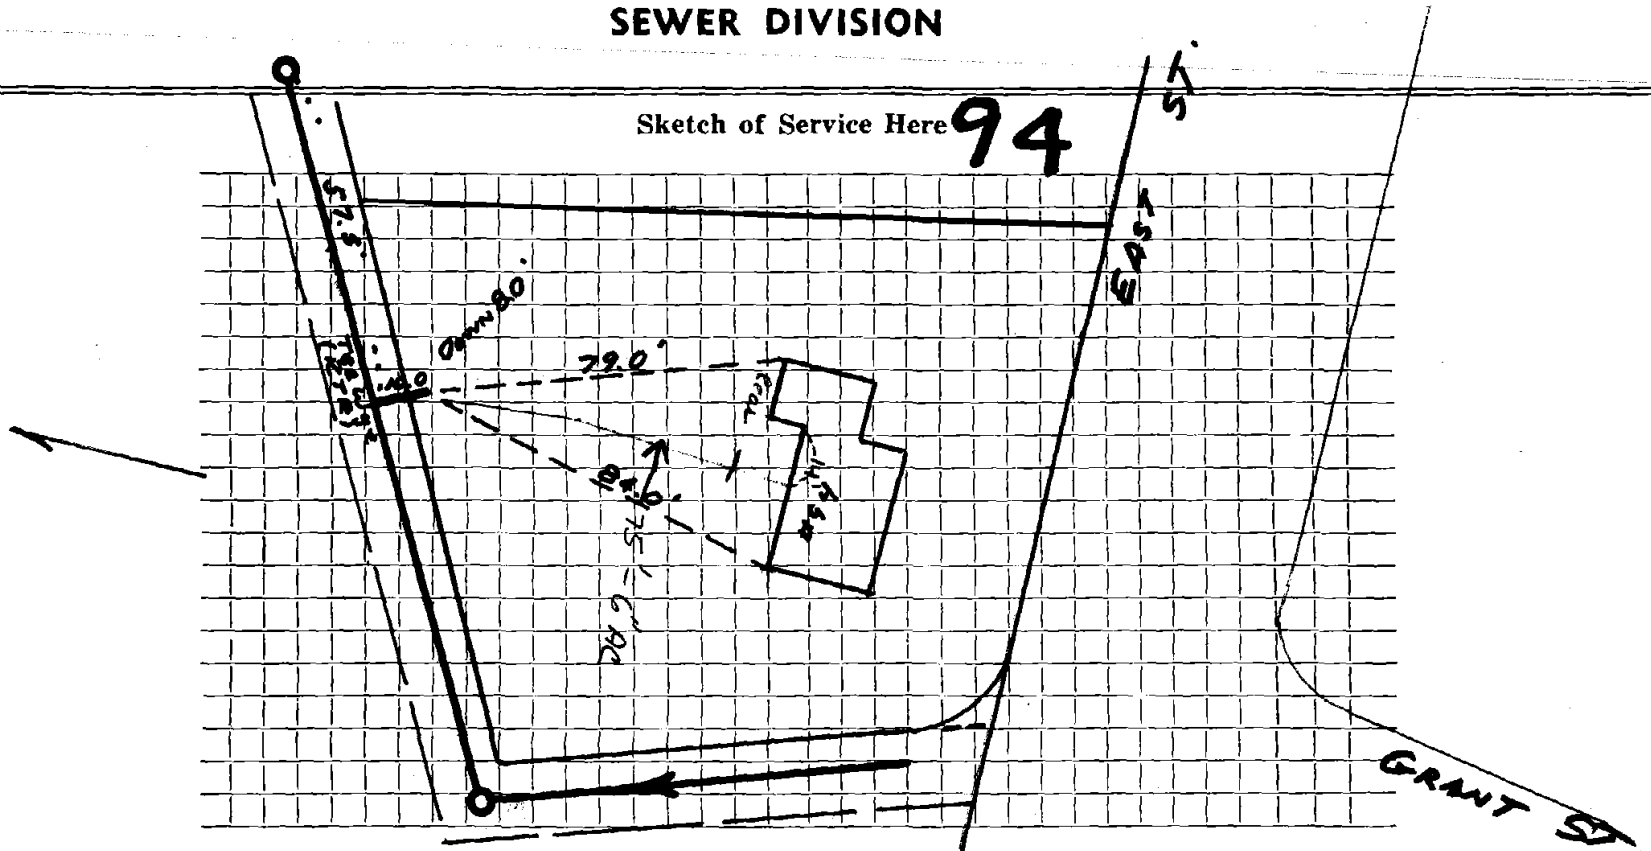

Connection made in ..... Street. Work completed .....

Remarks: .....

.....