

Name Kathleen O'Brien

Service No. 156

Address # 99 EAST ST.

Location

Kind of Pipe

Size 6" A.C.

Size of Main 8" A.C.

Repair—Renewal—New Service Alfiero DiBona #2797

Location AUG 16 1976


Date		Material	Amount	Total	Date		Amount
11/24/72		12.0' 6" PC @ \$9.00	\$108.00		12/8/5	Deposit	108.00
12/9/75	50'	6" Transit Pipe					
	10'	4" Cast Iron Pipe					
					10-24-72		
					12' 6" A.C.		

DATE _____

TOWN OF LEXINGTON — BOARD OF PUBLIC WORKS

SEWER DIVISION

Sketch of Service Here **99**

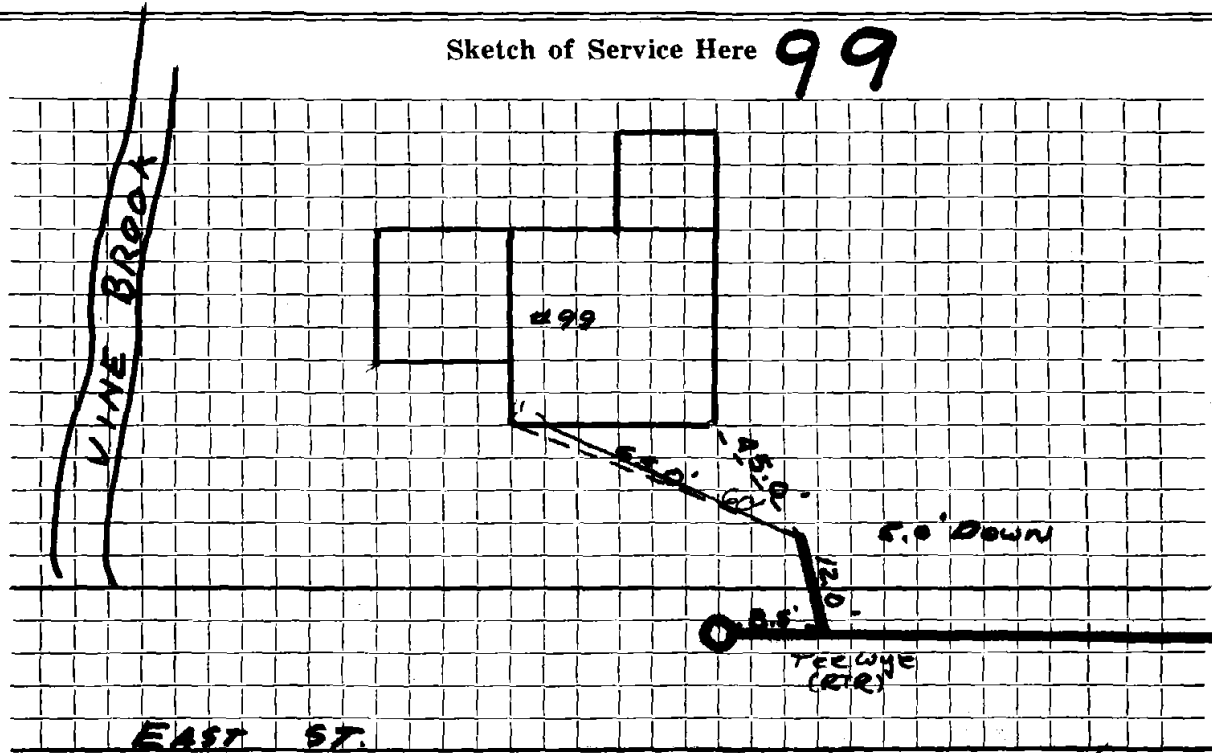

Connection made in **#99 EAST ST.** Street.

Work completed ... **12/9/75**

Remarks:

.....

.....