


DATE _____

TOWN OF LEXINGTON — BOARD OF PUBLIC WORKS
SEWER DIVISION

Sketch of Service Here **3**

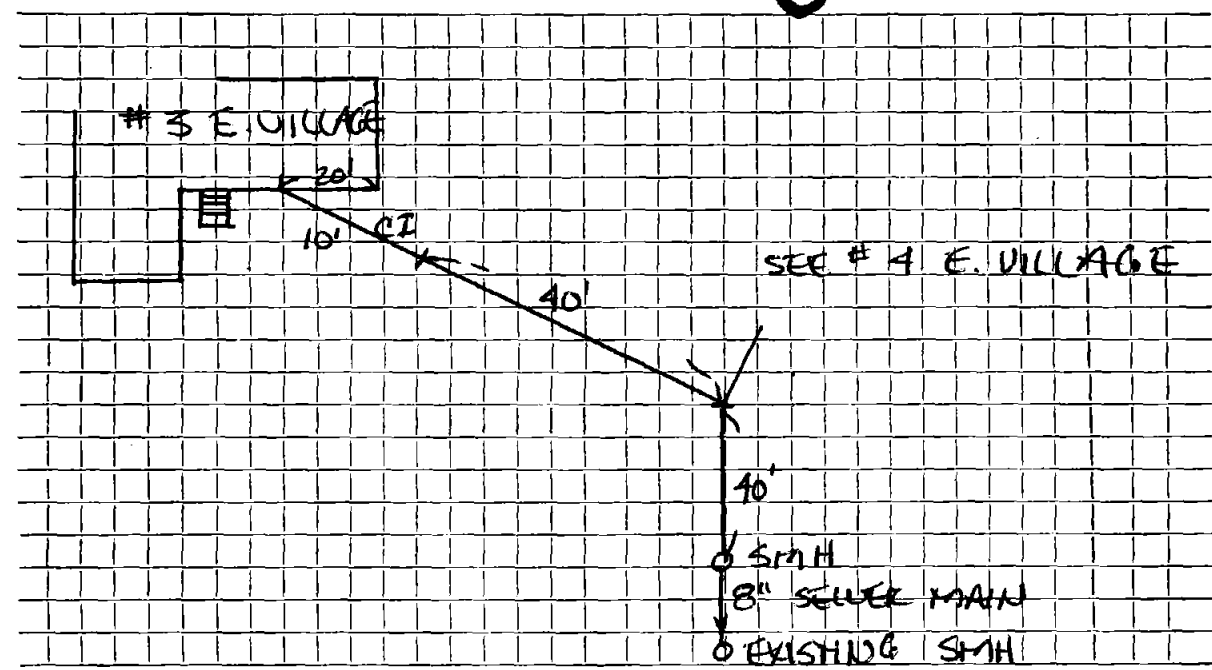

Connection made in SPENCER Street. Work completed 4/7/76

Remarks: _____

