


DATE _____

TOWN OF LEXINGTON — BOARD OF PUBLIC WORKS
SEWER DIVISION

Sketch of Service Here **4**

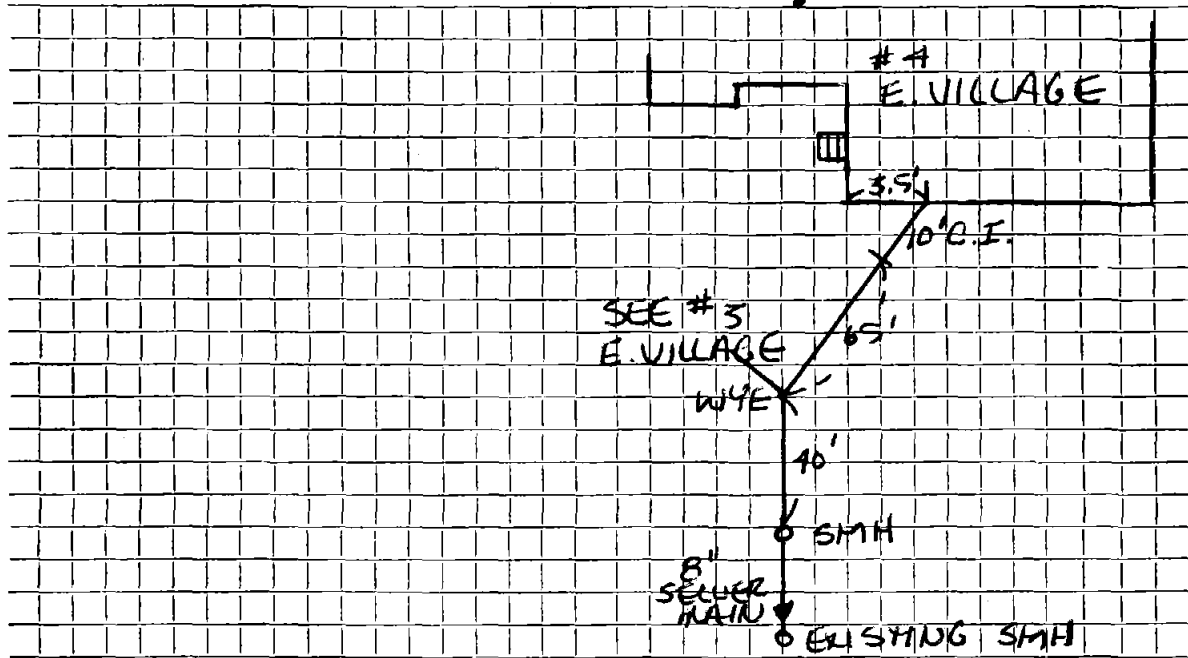

Connection made in ... SPENCER ... Street.

Work completed ... 4-7-76

Remarks:
.....
.....