


DATE _____

TOWN OF LEXINGTON — BOARD OF PUBLIC WORKS

SEWER DIVISION

Sketch of Service Here **5+6**

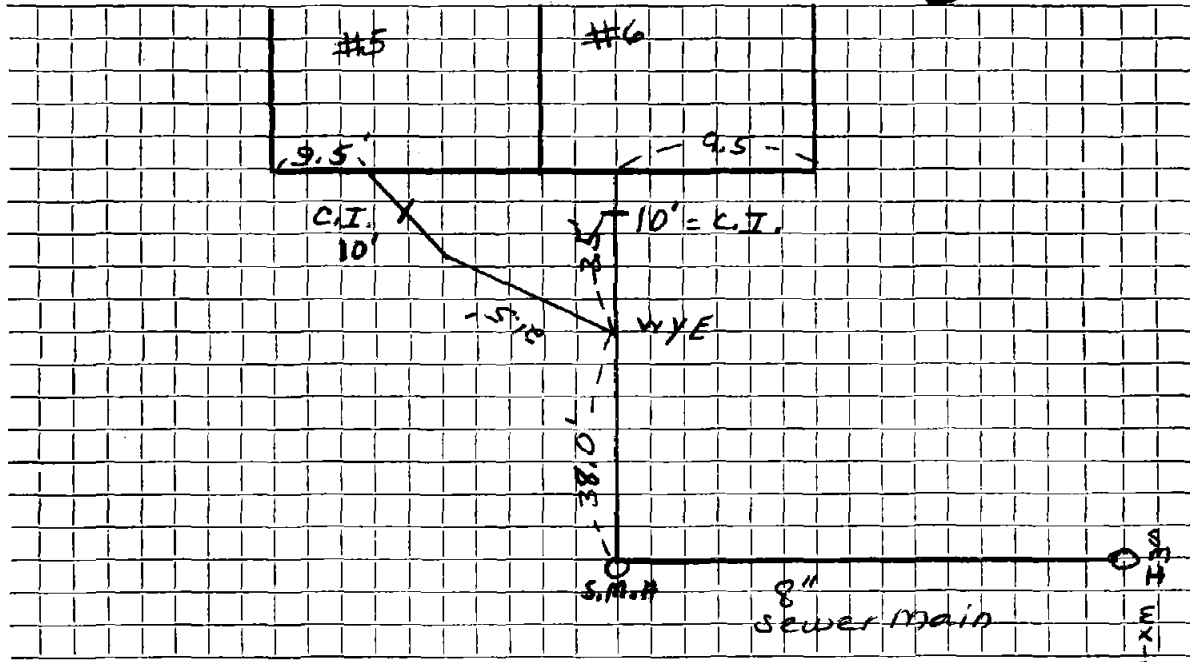

Connection made in Street. Work completed

Remarks:
.....
.....

S.W. 1st St
200