

Name Charles H. Murray

Service No. 275

Address 24 Eastern Ave.

Location

Kind of Pipe

Size

Size of Main

~~Repair~~ ~~Service~~ — New Service

Location *Comm 12-31-60*


Date	Material	Amount	Total	Date	Amount
5-10-60	Labor	27.08		<i>11-5-60</i>	<i>156.00</i>
	10% O. H.	2.71	29.79	<i>12-31-60</i>	<i>31.58</i>
	20' 6" Transite pipe @.78		15.60		<i>118.42</i>
	1 6" Duplex Adapter		1.90		
	1 hr. Trucking @3.00		3.00		
			56.79		
	SERVICE TO CURB BILL WHEN CONNECTED				
12-7-60	Labor	22.11			
	10% O. H.	2.21	24.32		
	37' 6" Transite pipe @.78		28.86		
	1 $22\frac{1}{2}$ " Transite Elbow		2.24		
	1 $22\frac{1}{2}$ " Transite ELBOW Bend		6.21		
			118.42		
				<i>Apply 10.20 to W.H.C. # 296</i>	

DATE _____

TOWN OF LEXINGTON — BOARD OF PUBLIC WORKS

SEWER DIVISION

Sketch of Service Here

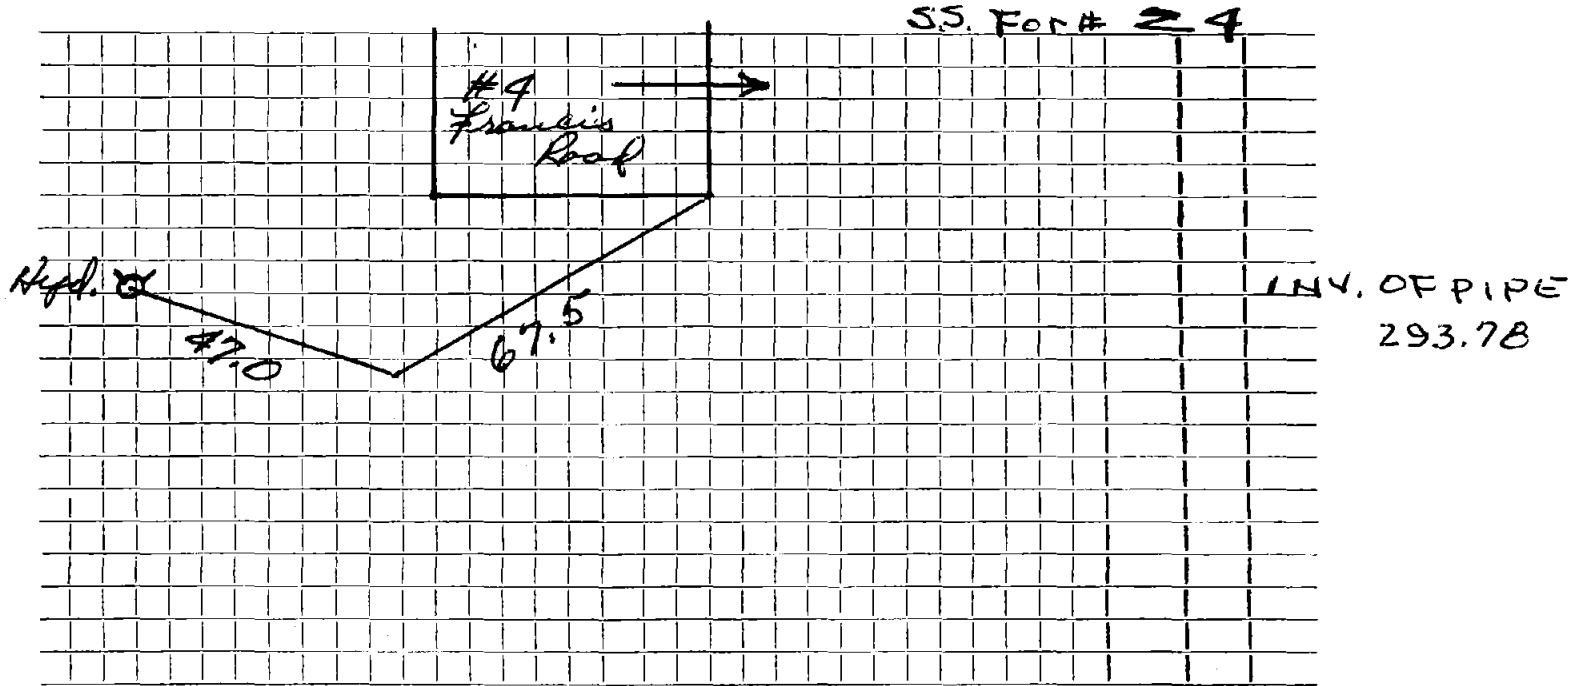

Connection made in Street. Work completed

Remarks:
.....
.....