

Name John Reicheld & John Gallagher

Service No. 121

Address 26 Eastern Ave

Location

Kind of Pipe

Size

Size of Main

~~Repair/Replace~~ **New Service**

Location

Comm 8-22-60


Date	Material	Amount	Total	Date	Amount
7-8-60	Labor	42 50		<i>7-2-60</i>	<i>Deposit</i> 350 00
	10% O.H.	<u>4 25</u>	46 75	<i>8-23-60</i>	<i>Retard</i> <u>26 81</u>
	25' 6" Transite pipe @78		19 50		323 19
1	11 $\frac{1}{4}$ " Transite Bend		5 10		
1	11 $\frac{1}{4}$ " Transite Elbow		2 24		
2	Hrs Town Shovel @6.50		13 00		
1	Hr Trucking @3.00		<u>3 00</u>		
			89 59		
	PREVIOUS CHARGE		<u>233 60</u>		
			323 19		

DATE _____

TOWN OF LEXINGTON — BOARD OF PUBLIC WORKS

SEWER DIVISION

Sketch of Service Here

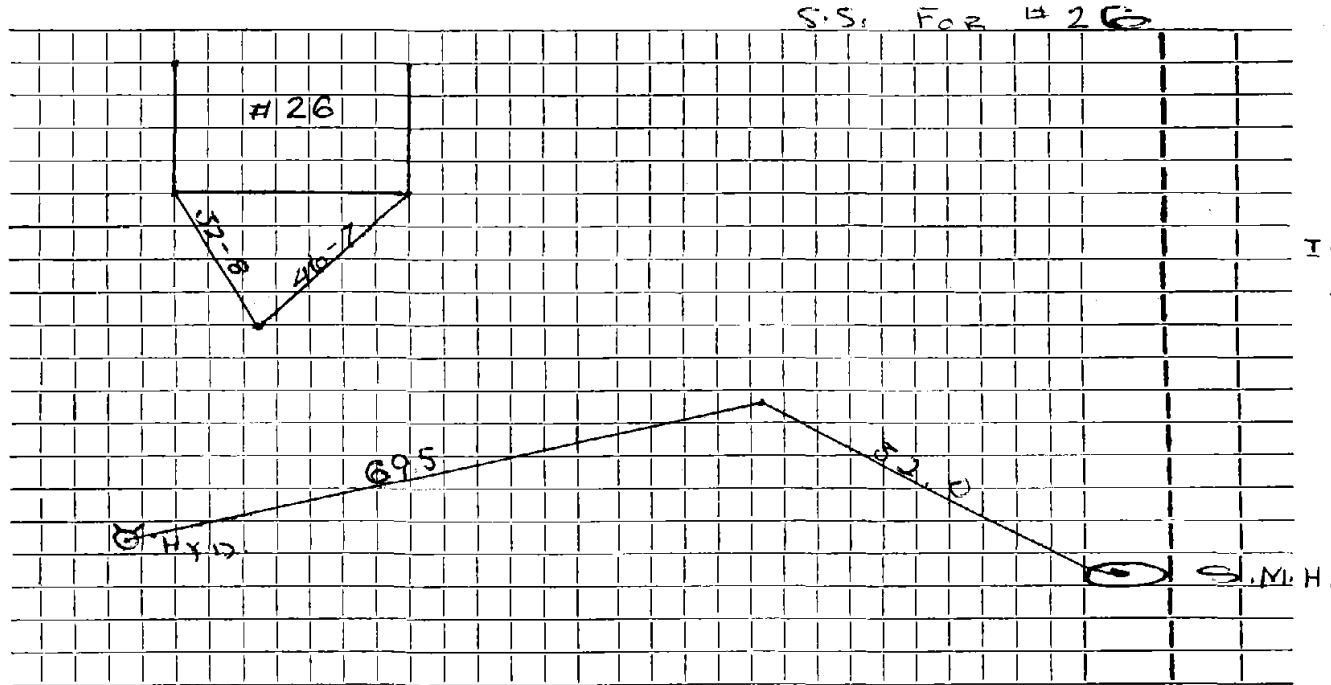

Connection made in Street. Work completed

Remarks:

.....

.....

Name

Service No.

Address

26 Eastern Ave.

Location

Kind of Pipe

Size

Size of Main

~~Repair~~ ~~Reconnect~~ **New Service**


Location

Date	Material	Amount	Total	Date	Amount
-11-60	Labor 78.25				
-12-60	" 37.57	115.82			
	10% O:H:	11.58	127.40		
	30' 6" Transite pipe @.78		23.40		
	60 Sticks Dynamite @.26		15.60		
	20 Blasting Caps @.28		5.60		
	8 ton Fill @.70		5.60		
	4 hrs. Town Shovel @5.50		26.00		
	4 hrs. Trucking @3.00		12.00		
	4 hrs. Compressor @3.00		12.00		
	1 hr. Dozer @3.00		3.00		
	1 hr. Trailer @3.00		3.00		
			<u>233.60</u>		
	SERVICE TO CURB BILL WHEN CONNECTED				
	5 1/2 feet deep				

DATE _____

TOWN OF LEXINGTON — BOARD OF PUBLIC WORKS
SEWER DIVISION

Sketch of Service Here

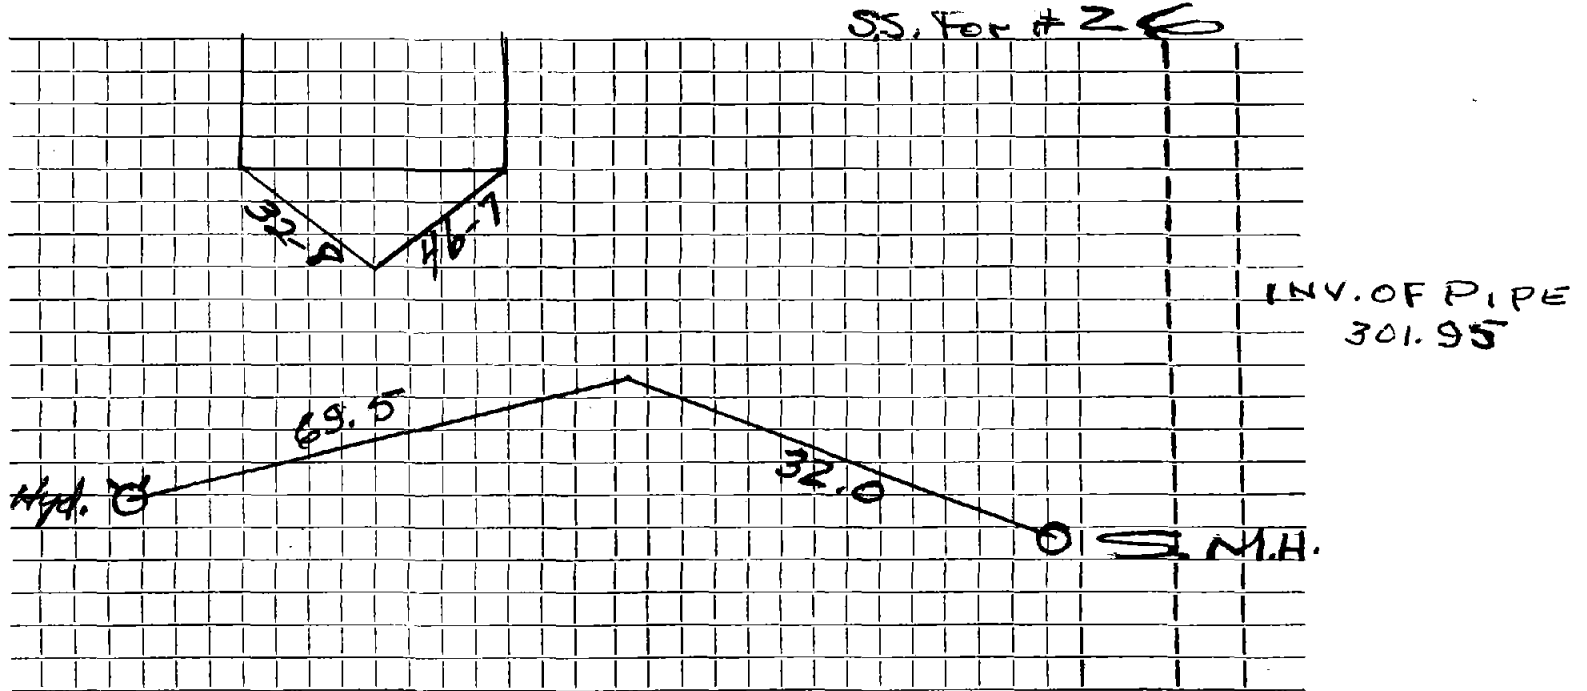

Connection made in Street. Work completed

Remarks:

.....

.....