


DATE _____

TOWN OF LEXINGTON — BOARD OF PUBLIC WORKS
SEWER DIVISION

Sketch of Service Here

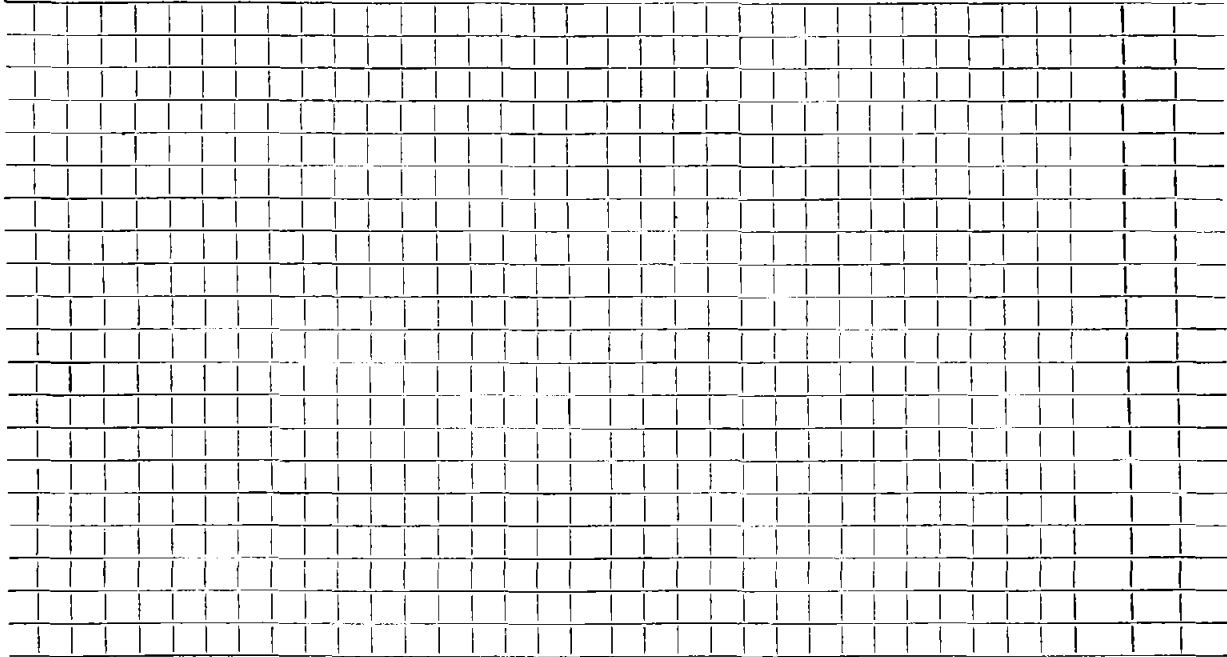

Connection made in Street. Work completed

Remarks:
.....
.....

Name

Service No.

Address # 29 Eastern Ave.

Location

Kind of Pipe

Size

Size of Main

~~Repair or Renewal~~ New Service

Location


Date	Material	Amount	Total	Date	Amount
7-7-60	Labor	70.59			
	10% O. H.	7.06	77.65		
	17' 6" Transite pipe @.78		13.26		
	47 Sticks Dynamite @.26		12.22		
	12 Blasting Caps @.28		3.36		
	1 22 $\frac{1}{2}$ ° Transite Bend		6.21		
	6 hrs. Town Shovel @6.50		39.00		
	2 hrs. Trucking @3.00		6.00		
	3 hrs. Compressor @3.00		9.00		
	1 hr. Bulldozer @3.00		3.00		
	BILL WHEN CONNECTED		169.70		

DATE _____

TOWN OF LEXINGTON — BOARD OF PUBLIC WORKS

SEWER DIVISION

Sketch of Service Here

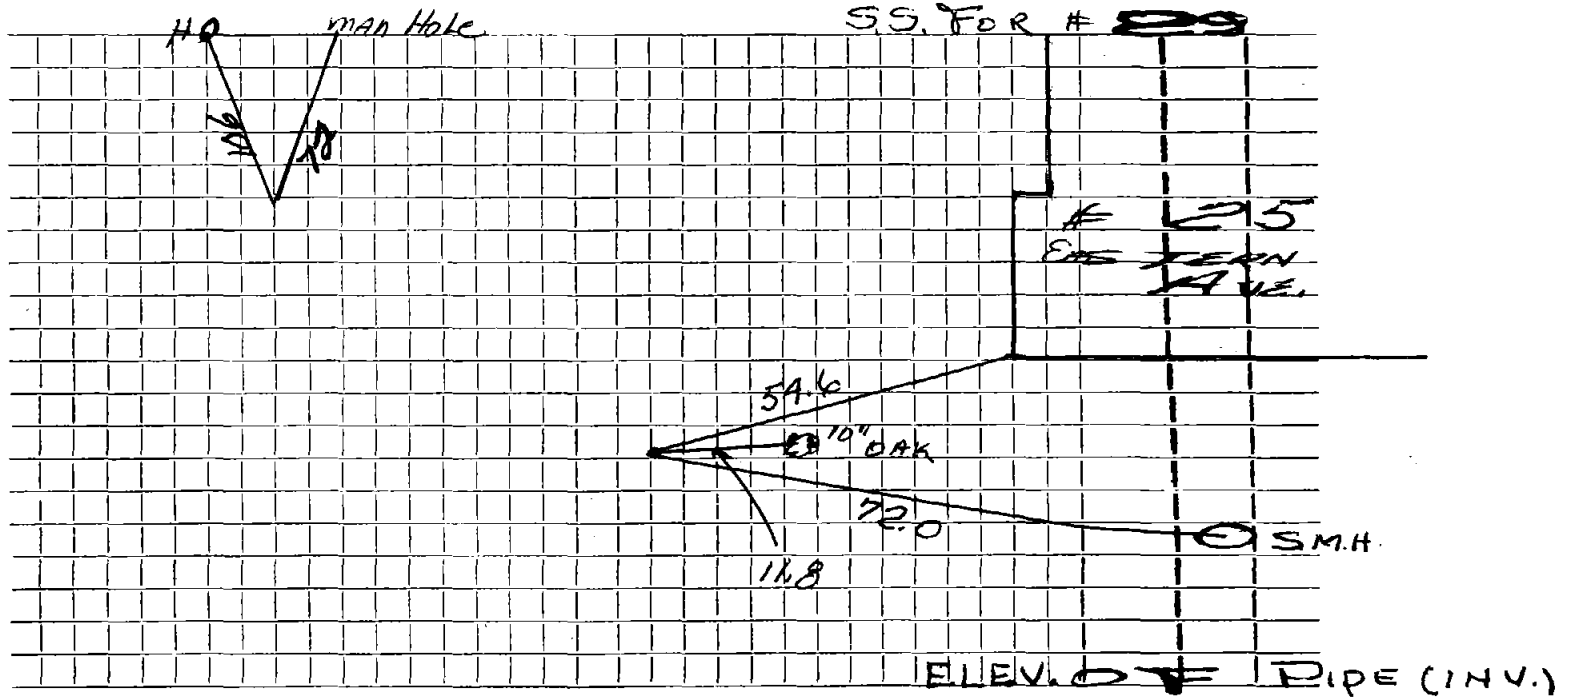

Connection made in Street. Work completed 307.69

Remarks:

.....

.....