

Name **Herbert McConchie**

Service No. **99**

Address **30 Haste rn Ave.**

Location

Kind of Pipe

Size

Size of Main

~~Repair~~ ~~Renewal~~ — **New Service**

Location *Comm 9-25-61*


Date	Material	Amount	Total	Date	Amount
7-7-60	Labor	74 81		8-1-61	Deposit 225 00
	10 % O.H.	7 48	82 29	9-25-61	Retund 36 47
	24' 6" Transite pipe @.78		18 72		188 53
	12 sticks Dynamite		3 12		
	5 blasting Caps		1 40		
	3 Hrs. Town shovel	6.50	19 50		
	1 Hr. Compressor	3.00	3 00		
	3 Hrs. Trucking	3.00	9 00		
	BILL WHEN CONNECTED		137 03		
8-3-61	Labor	18.18			
	10% O.H.	1.82	20.00		
	30' 6" Transite pipe @.78		23.40		
	1 11 1/2" Transite Bend		5.10		
	1 hr. Trucking @3.00		3.00		
			188.53		

DATE _____

TOWN OF LEXINGTON — BOARD OF PUBLIC WORKS

SEWER DIVISION

Sketch of Service Here

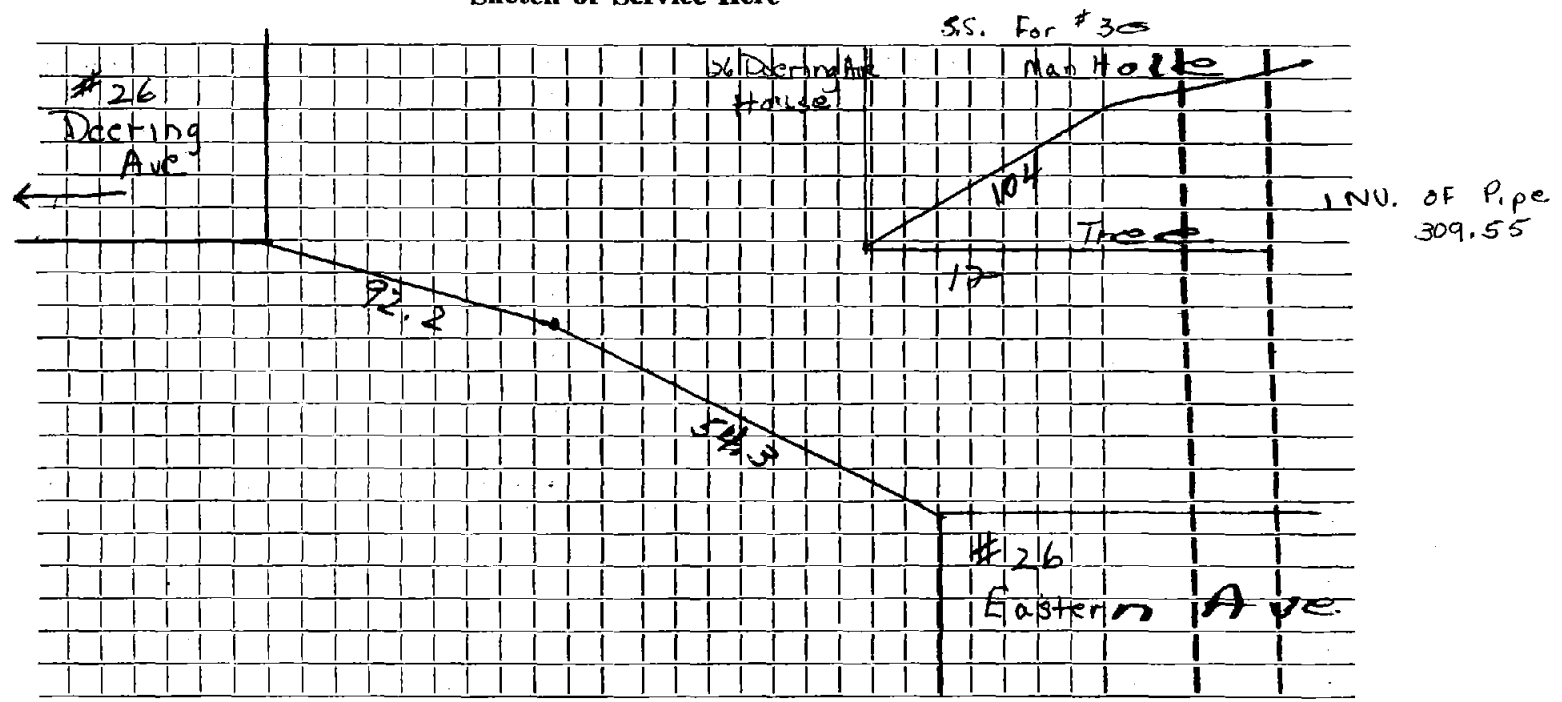

Connection made in Street. Work completed

Remarks:

.....

.....