

Name **Herbert McConchie**Service No. **45**Address **# 32 Eastern Ave.**

Location

Kind of Pipe

Size

Size of Main

~~Repair~~ **New Service**Location *Comm 4-18-61*


Date	Material	Amount	Total	Date		Amount
7-6-60	Labor	70.59		5-10-61	Deposit	225.00
	10% O.H.	7.06	77.65	4-19-61	Retund	32.69
	25' 6" Transite pipe @.78		19.50			192.33
	1 6" Transite Elbow 90°		5.40			
	25 Sticks Dynamite @.26		7.00			
	9 Blasting Caps @.28		2.52			
	3 hrs Town Shovel @6.50		19.50			
	2 hrs. Trucking @3.00		6.00			
	2 hrs. Compressor @3.00		6.00			
	1 hr. Allis Chalmer @3.00		3.00			
	<u>BILL WHEN CONNECTED</u>		146.57			
5-19-61	Labor	17.22				
	10% O.H.	1.72	18.94			
	24' 6" Transite pipe @.78		18.72			
	1 11 1/4" Transite Bend		5.10			
	1 Hr. Trucking @3.00		3.00			
			192.33			

DATE _____

TOWN OF LEXINGTON — BOARD OF PUBLIC WORKS

SEWER DIVISION

Sketch of Service Here

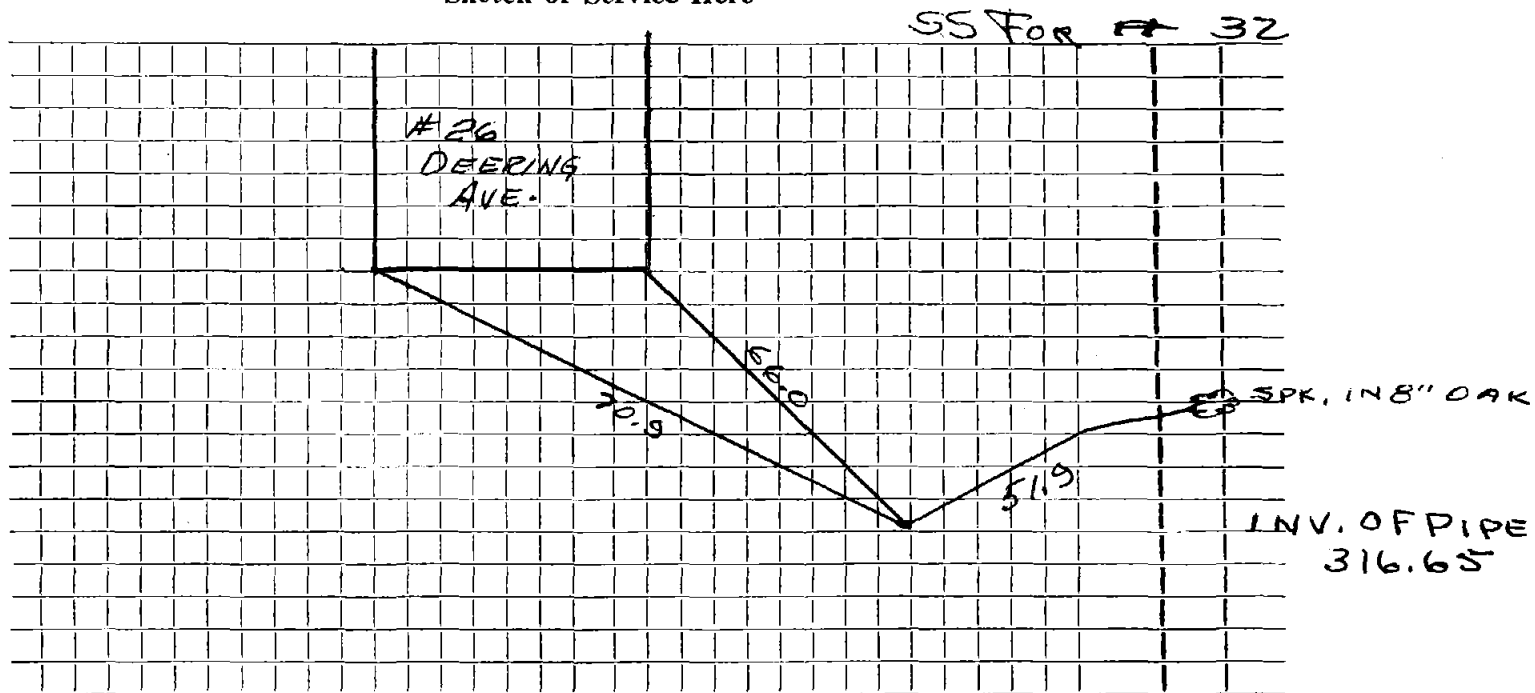

Connection made in Street. Work completed

Remarks:

.....

.....