

Name Charles H. Murray

Service No. 116

Address 36 Eastern Ave

Location

Kind of Pipe

Size

Size of Main

~~Repair~~ ~~Renewal~~ **New Service**

Location *Comm 8-1-60*


Date	Material	Amount	Total	Date	Amount
7-5-60	Labor	18 75		7-1-60	Deposit 200 00
7-6-60	"	53 70		8-1-60	Paid by WHC #110 7 79
		72 45		9-6-60	Paid <u>7 61</u>
	10% O. H.	7 25	79 70		212 40
50'	6" Transite pipe @78		39 00		NON CHARGE
30	Sticks Dynamite @26		7 80	7-6-60	Labor 50 00
16	Blasting Caps		4 48		50' 6" Transite pipe @78-39 00
2	22 1/2° Transite Bends @6.21		12 42		89 00
6	Hrs Town Shovel @6.50		39 00		
3	Hrs Trucking @3.00		9 00		
4	Hrs Compressor @3.00		12 00		
2	Hrs Allis Chalmers @3.00		6 00		
1	Hr Trailer @3.00		3 00		
			212 40		

DATE _____

TOWN OF LEXINGTON — BOARD OF PUBLIC WORKS

SEWER DIVISION

Sketch of Service Here

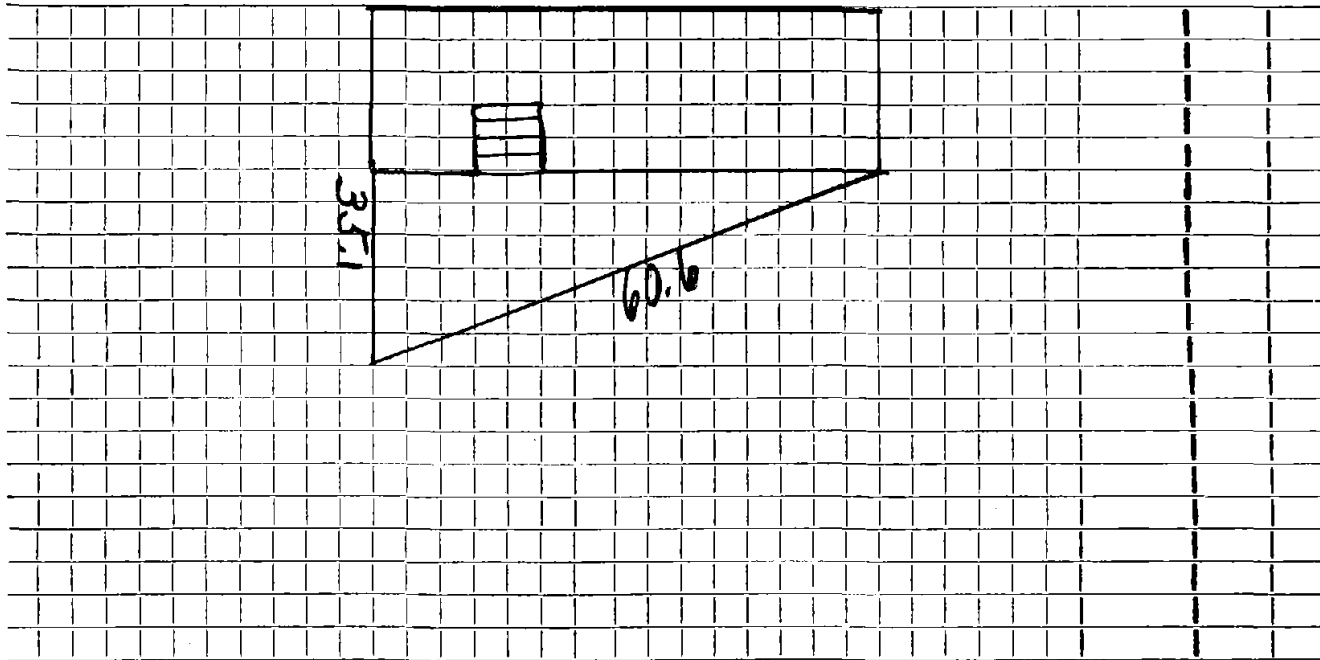

Connection made in Street. Work completed

Remarks:

.....

.....