

Name William Caterino

Service No. 89 N.D.

Address <sup>38</sup>~~40~~ Eastern Avenue

Location

Kind of Pipe

Size

Size of Main

~~Repair - Renewal~~ New Service


Location *Conn 7-5-60*

Date	Material	Amount	Total	Date	Amount
1-59	Labor	85 40		<del>7-3-60</del>	<del>129 64</del>
	10% O. H.	8 54	93 94		
	21' 6" Transite pipe @.70		14 70		
	3 Hrs. Town Shovel @6.50		19 50		
	2 Hrs. Trucking @.75		1 50		
			129 64		
	BILL WHEN CONNECTED				
	<i>The results lot</i>				
	<i>Bill William Caterino</i>				
	<i>for T-115</i>				

DATE \_\_\_\_\_

TOWN OF LEXINGTON — BOARD OF PUBLIC WORKS  
SEWER DIVISION

Sketch of Service Here

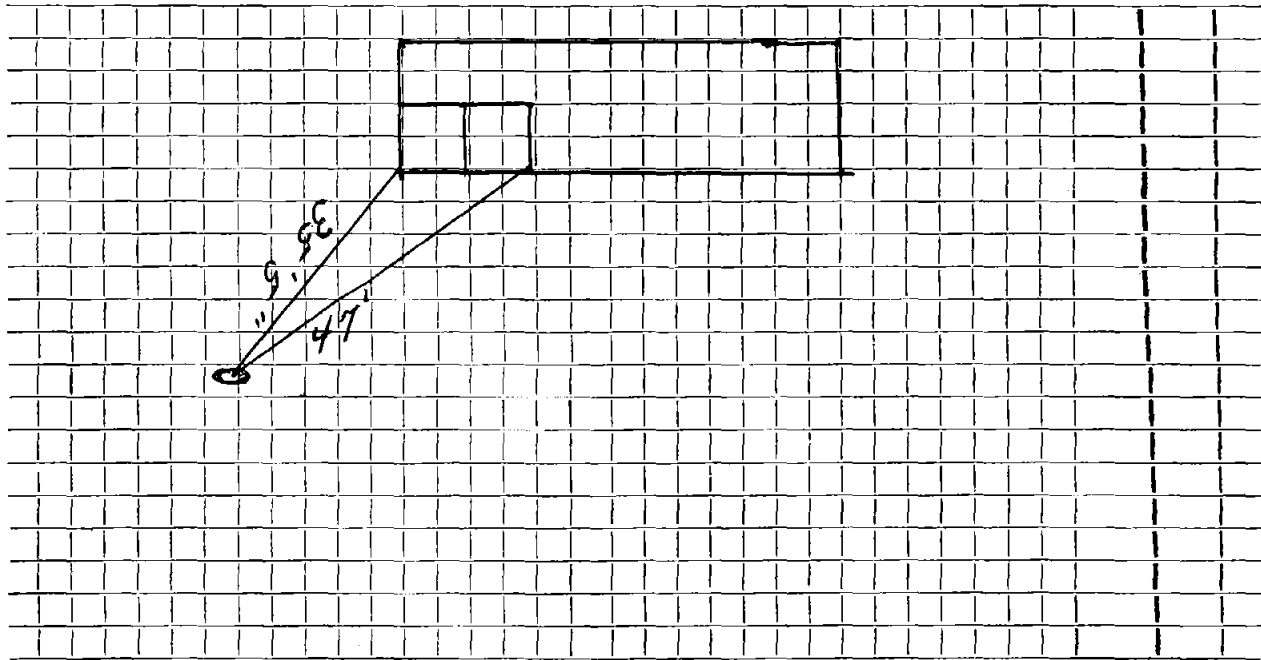

Connection made in ..... Street. Work completed .....

Remarks: .....

.....


.....



DATE \_\_\_\_\_

**TOWN OF LEXINGTON — BOARD OF PUBLIC WORKS**  
**SEWER DIVISION**

Sketch of Service Here

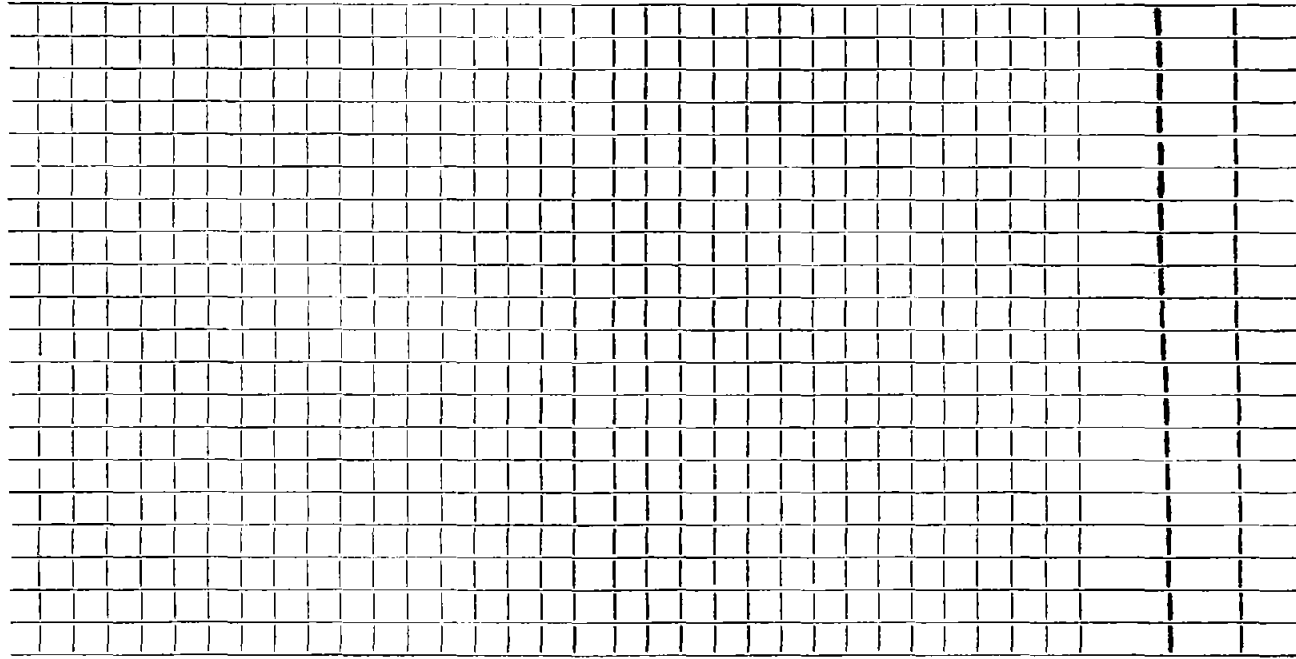

Connection made in ..... Street.      Work completed .....

Remarks: .....  
.....  
.....



