

Name **Herbert McConchie**

Service No. **68**

Address **42 Eastern Ave.**

Location

Kind of Pipe

Size

Size of Main

~~Repair~~ **New Service**

Location

*Comm 7-5-60*


Date	Material	Amount	Total	Date	Amount
5-7-60	Labor	24.99		5-6-60	200.00
	10 % O.H.	2.50	27 49	7-5-60	4.08
	24' 6" Transite Pipe @ .78		18 72		195.92
	1 6" Duplex Adapter		1 90		
	2 22" Transite Bend @ 6.21		12 42		
	1 11" Transite Bend		5 10		
			65 63		
	PreVIOUS Charge		130 29		
			195 92		

DATE \_\_\_\_\_

TOWN OF LEXINGTON — BOARD OF PUBLIC WORKS

SEWER DIVISION

Sketch of Service Here

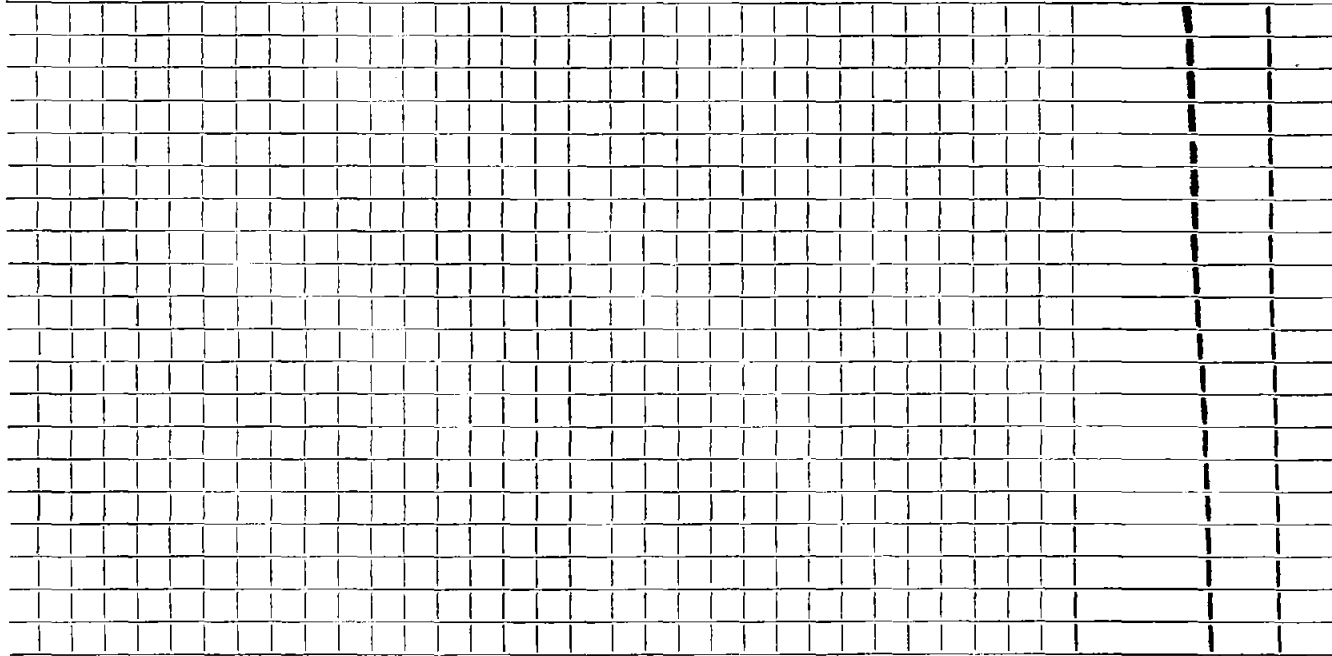

Connection made in ..... Street. Work completed .....

Remarks: .....

.....

.....

Name

Service No.

Address 12 Eastern Avenue

Location

Kind of Pipe

Size

Size of Main

~~Repair~~ **New Service**


Location

Date	Material	Amount	Total	Date	Amount
1-29-59	Labor	57 96			
	10% O. H.	5 80	63 76		
	20' 6" Transite pipe @.70		14 00		
	30 Sticks dynamite @.26		7 80		
	16 Caps @.28		4 48		
	1/2 Hrs. TOWN Shovel @6.50		26 00		
	3 Hrs. TRucking @.75		2 25		
	1/4 Hrs. C Ompressor @3.00		12 00		
			130 29		
	BILL. WHEN CONNECTED				

TOWN OF LEXINGTON — BOARD OF PUBLIC WORKS

SEWER DIVISION

Sketch of Service Here

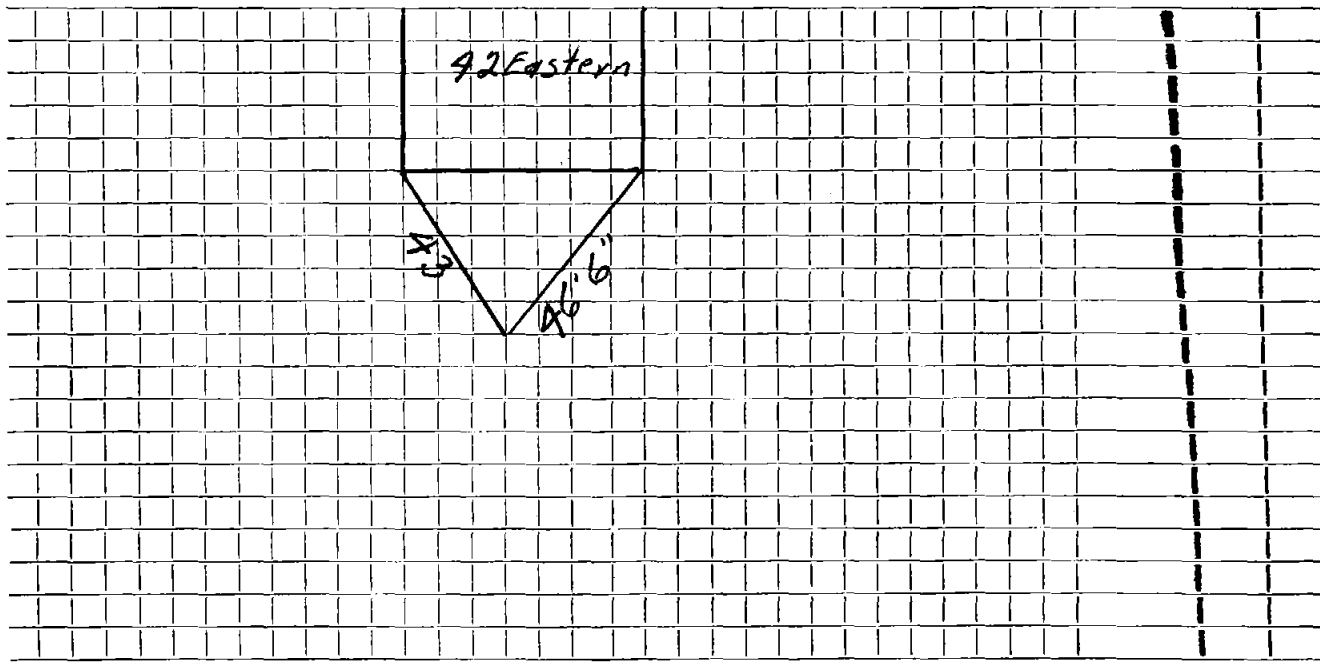

Connection made in ..... Street. Work completed .....

Remarks: .....  
.....  
.....