

Name **John Reichheld & John Gallagher**

Service No. **111**

Address **144 Eastern Avenue**

Location

Kind of Pipe

Size

Size of Main

~~Repair/Renewal~~ **New Service**

Location **Comm 8-1-60**

Date	Material	Amount	Total	Date	Amount
7-31-59	Labor	59 60		6-27-60	Deposit 170 00
	10% O. H.	5 96	65 56	9-1-60	Retard 17 97
	17' 6" Transite pipe @.70		11 90		152 03
	3 Hrs. Town Shovel @6.50		19 50		
	2 Hrs. Trucking @.75		1 50		
			98 46		
	BILL WHEN CONNECTED				
-29-60	Labor	14.89			
	10% O. H.	1.49	16 38		
	33' 6" Transite pipe @.78		25 74		
	1 22½° Transite elbow		2 24		
	1 22½° transite bend		6 21		
	1 hr. trucking @ 3.00		3 00		
	PROV. CHARGE		192 03		


DATE _____

TOWN OF LEXINGTON — BOARD OF PUBLIC WORKS

SEWER DIVISION

Sketch of Service Here

44

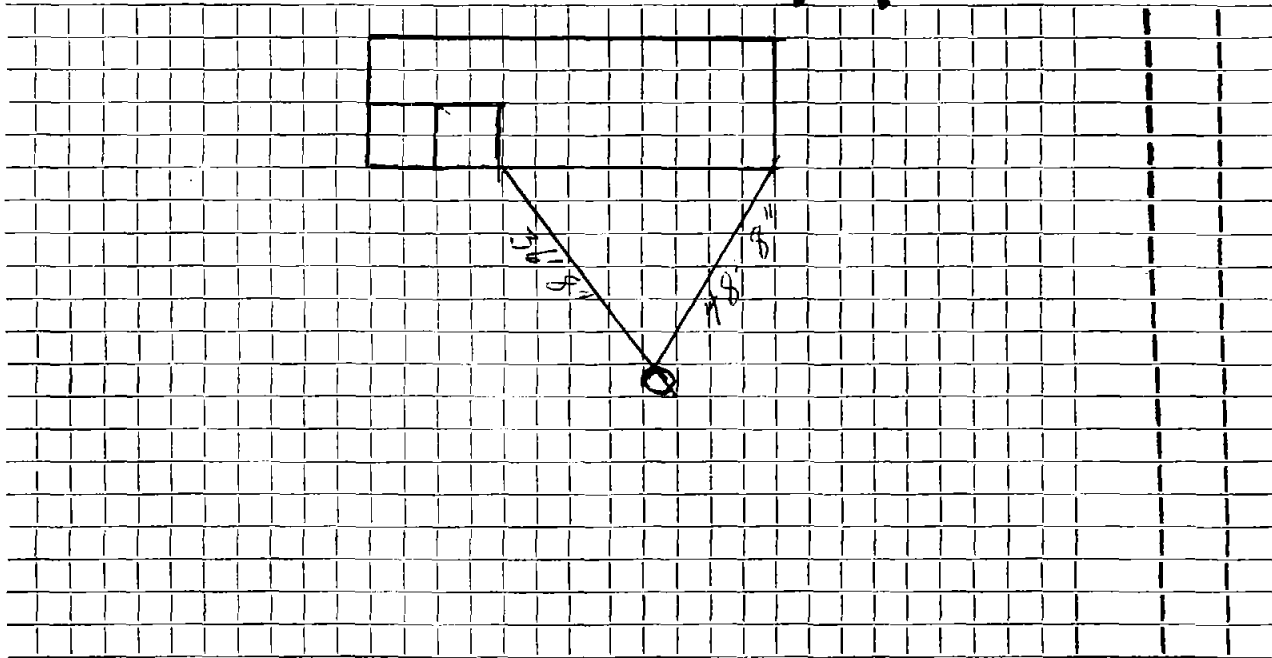

Connection made in Street. Work completed

Remarks:
.....
.....