

Name **Herbert McConchie**

Service No. **70**

Address **46 Eastern Avenue**

Location

Kind of Pipe

Size

Size of Main

~~Repair~~ ~~Renewal~~ **New Service**

Location

Comm 5-16-60


Date	Material	Amount	Total	Date	Amount
-9-60	Labor	78.90		<i>5-9-60</i>	<i>Deposit</i> 500.00
	10% O.H.	7.89	86.79	<i>5-16-60</i>	<i>Retard</i> 254.33
	71' 6" Transite pipe @.78		55.38		<u>225.67</u>
	7 ton. Sand @1.00		7.00		
	10 ton Fill @.70		7.00		
	7 hrs. Town Shovel @6.50		45.50		
	3 hrs. Trucking @3.00		9.00		
	1 hr. Compressor @3.00		3.00		
	12 x 3 Patch		12.00		
			<u>225.67</u>		

DATE _____

TOWN OF LEXINGTON — BOARD OF PUBLIC WORKS

SEWER DIVISION

Sketch of Service Here **46**

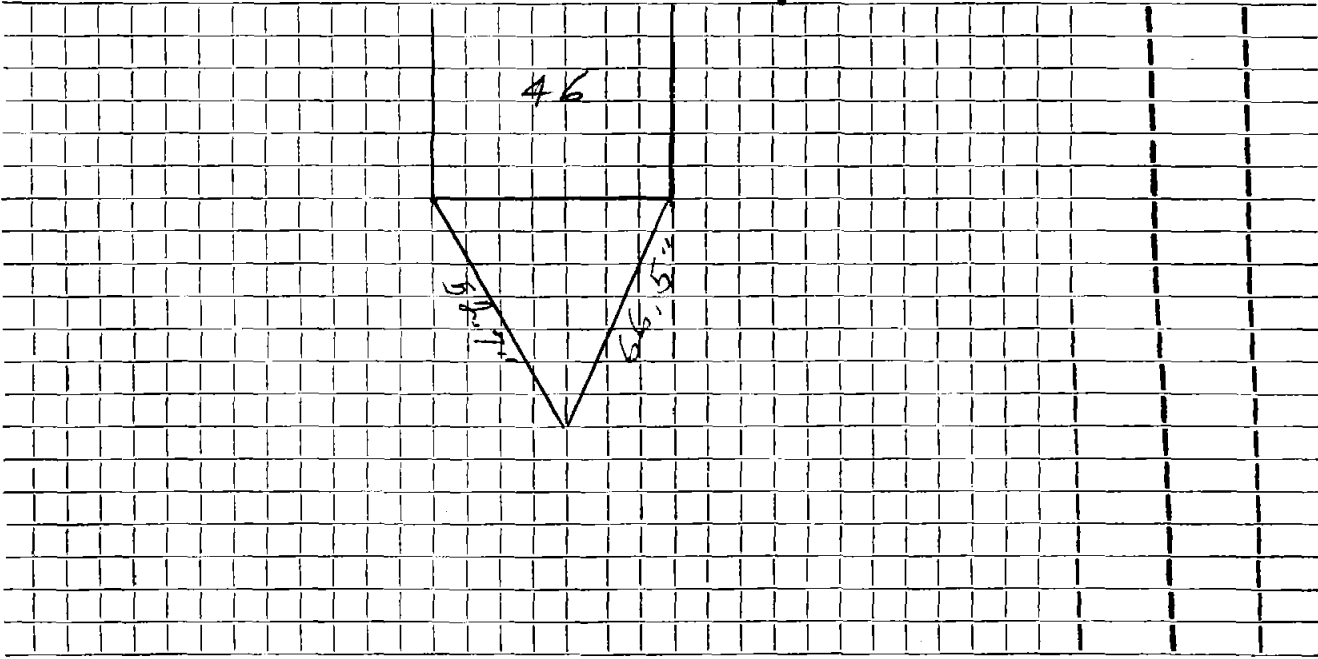

Connection made in Street. Work completed

Remarks:
.....
.....