

Name H. M. Besecker

Service No. 114

Address #8 Eastern Ave

Location

Kind of Pipe

Size

Size of Main

~~Repair/Rehaul~~ — New Service

WO# 8184

Location *Comm 2-10-64*

Date	Material	Amount	Total	Date	Amount
9/13/63	Labor	62 72		9-5-63	150 00
	10% O.H.	6 27	68 99	2-10-64	25 93
	41' 6" Transite Pipe @ .82		36 08		124 09
	2 Hrs. Trucking @ 3.00		6 00		
	2 Hrs. Town Shovel @ 6.50		13 00		
			124 07		
8014-63	12' 6" Transite Pipe				
	1 11 1/4° Transite Bend				
	1 Adapter				


DATE _____

TOWN OF LEXINGTON — BOARD OF PUBLIC WORKS
SEWER DIVISION

Sketch of Service Here

8

New Tie 1963

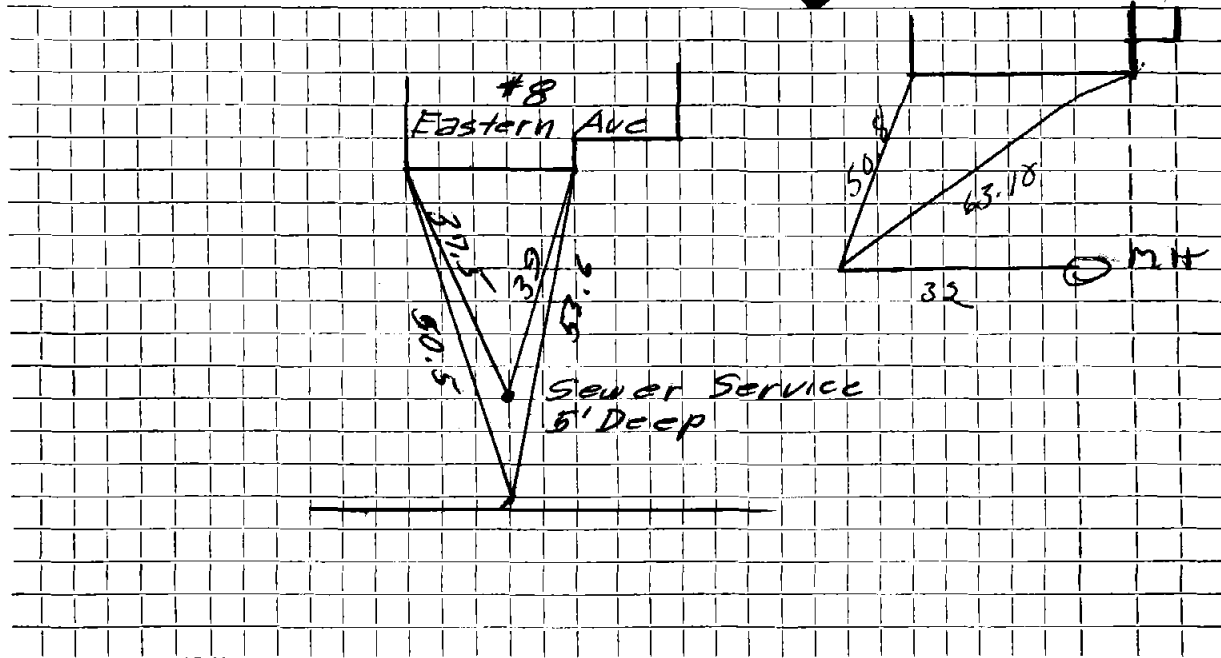

Connection made in Street. Work completed

Remarks:

.....
.....