

Name Mrs. George Gardner

Service No. 65

Address 11 Eaton Road

Lexington

Location

Kind of Pipe

COM. 6-16-52

Size

Size of Main

~~Repair~~ ~~Renewal~~ — New Service

Location

Date	Material	Amount	Total	Date	Amount
5/14/52	Labor	37 01		5-6-52	125 00
	10% overhead	3 70	40 71	6-16-52	(20 01)
	52' - 6" sewer pipe @ .342		17 78		104 99
	1 - 6" elbow		1 88		
	joint compound		3 12		
	4 hrs. Littlefield shovel		28 00		
	2 hrs. trucking		1 50		
	patching 12 x 3		12 00		
			104 99		
					RENEW
					04-07-00
					1 CYG FENG
					35' 6" PVC

TOWN OF LEXINGTON—DEPT. OF PUBLIC WORKS  
**SEWER DIVISION**

DATE ..... NO. ....


The undersigned applies for the construction of a particular sewer connecting No. ....  
Street and hereby agrees to comply with the Rules and Regulations governing the construction and use of Particular  
Sewers, as now or at any future time established by the Board of Selectmen.

Am't of estimate \$.....

Am't Paid \$.....

..... Owner

Sketch of Service Here

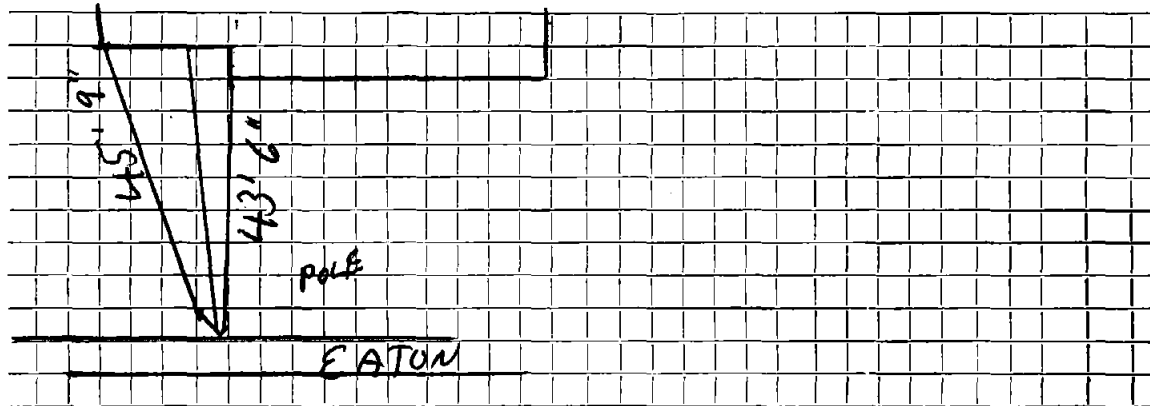

Connection made in ..... Street.

Work completed ..... 19..

Remarks: