




DATE \_\_\_\_\_

TOWN OF LEXINGTON — BOARD OF PUBLIC WORKS

SEWER DIVISION

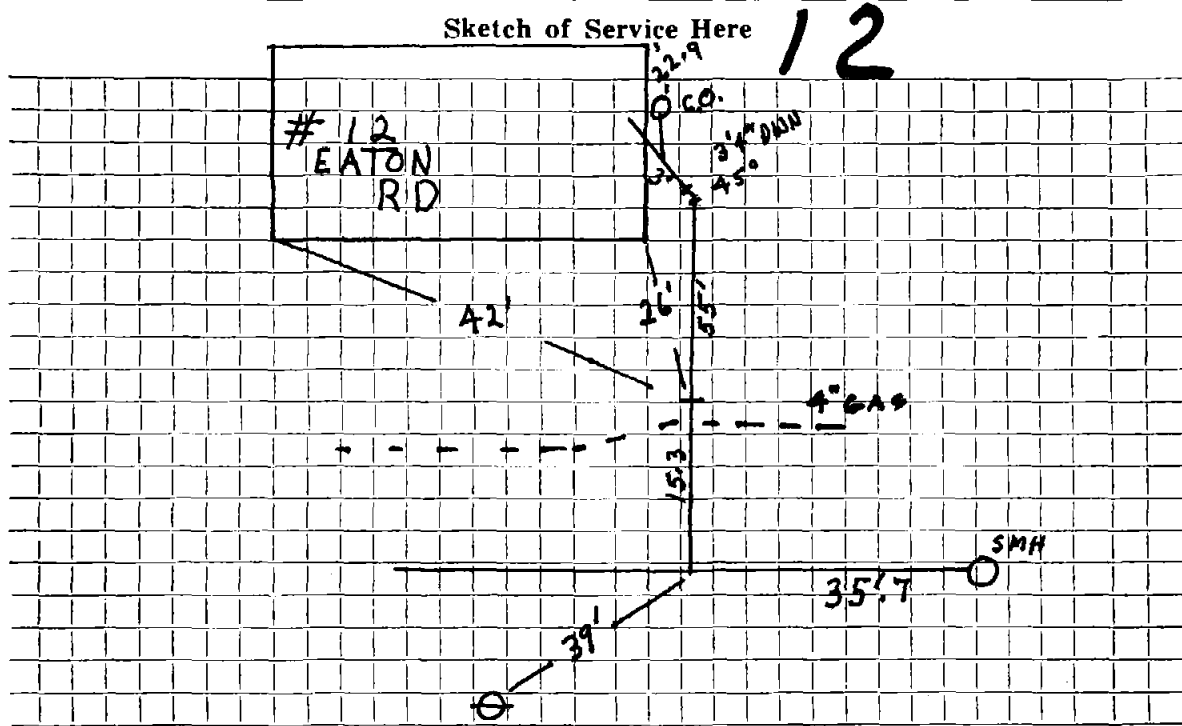

Connection made in \_\_\_\_\_ Street.

Work completed <sup>TOWN</sup> 9-7-93 out IN 11-93 ARLEX .....

Remarks: ENG. DID NOT SHOW UP TO INSPECT PIPE. ARLEX GAVE J.W. INFO. .....

ORIGINAL SERVICE INST. 12-17-52. .....