

DATE 10-24-'91


TOWN OF LEXINGTON — BOARD OF PUBLIC WORKS

SEWER DIVISION

#16 EATON Rd.

Sketch of Service Here

16

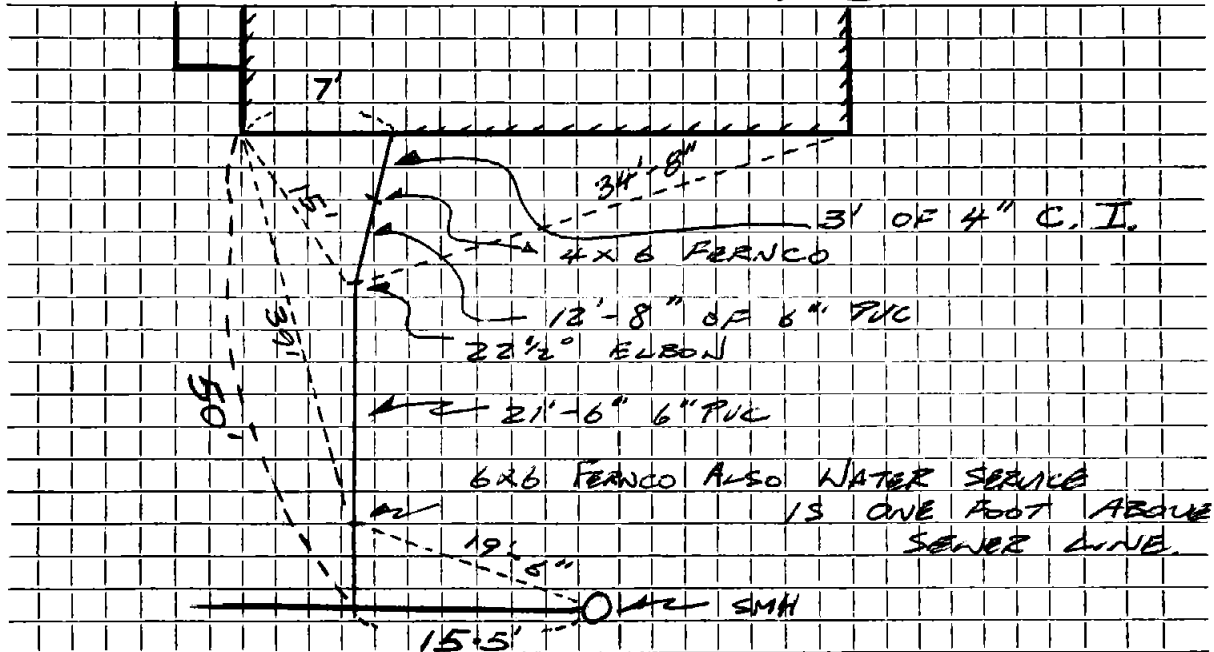

Connection made in #16 EATON Rd. ~~Street~~ Work completed

Remarks:
.....
.....