

Name Ernest E. Outhet

Service No. 79

Address 20 Eaton Road, Lexington

Location

Comm. 11-19-56

Kind of Pipe

Size

Size of Main

~~Repair~~ ~~Renewal~~—New Service

Location

Date		Material	Amount		Total		Date		Amount
7/10/56		Labor	56	33			6-26-56	Deposit	\$ 150 00
		10% Overhead	5	63	61	96	11-19-56	Refund	10 83
		58'6" Sewer Pipe @.435	25	23	25	23			139 17
		Joint Compound	3	48	3	48			
		4 hrs. Town Shovel @6.00			24	00			
		2 hrs. Trucking .75			1	50			
		2-3x3 Patching			23	00			
					139	17			
		Labor							

TOWN OF LEXINGTON—DEPT. OF PUBLIC WORKS  
**SEWER DIVISION**

DATE .....

NO. ....


The undersigned applies for the construction of a particular sewer connecting No. ....  
 Street and hereby agrees to comply with the Rules and Regulations governing the construction and use of Particular  
 Sewers, as now or at any future time established by the Board of Selectmen.

Am't of estimate \$. ....

Am't Paid \$. ....

..... Owner

**Sketch of Service Here**

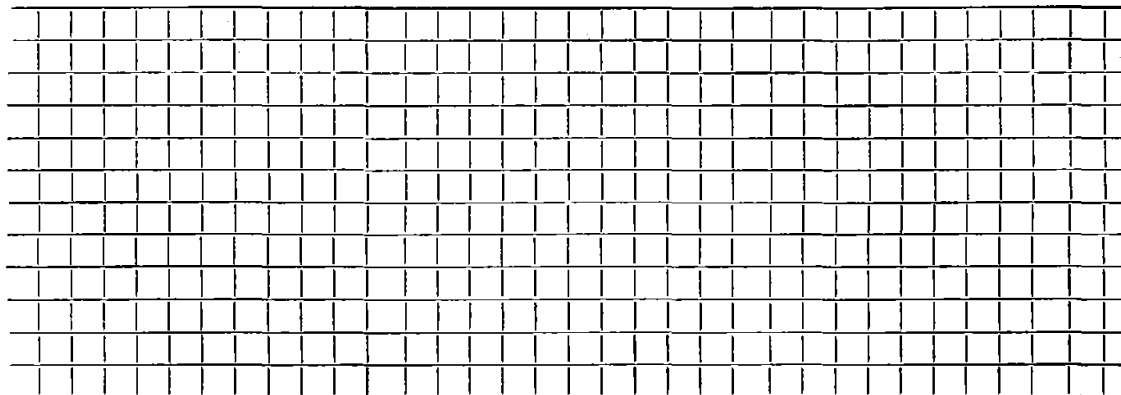

Connection made in ..... Street.

Work completed ..... 19..

Remarks: