

Name Leeland Const. Co.

Service No. 87

Address 24 Eaton Road

Location

Kind of Pipe

Size

Size of Main

Repair—Renewal—New Service

Location *Comm 11-24-58*

Date	Material	Amount	Total	Date	Amount
6/19/58	Labor	49 76		6-15-58	150 00
	10% overhead	5 98	54 74	11-24-58	16 63
	50' - 6" Transite pipe @ .70		35 00		133 37
	1 - 6" Clay Elbow		1 88		
	1 hr. Trucking		75		
	2 hrs. Town shovel @ 6.50		13 00		
	1 hr. Rodgers Trailer		3 00		
	1 hr. Trucking		3 00		
	22x3 Patch		22 00		
			133 37		
	Labor				

TOWN OF LEXINGTON—DEPT. OF PUBLIC WORKS
SEWER DIVISION

DATE.....

NO.


The undersigned applies for the construction of a particular sewer connecting No.....
Street and hereby agrees to comply with the Rules and Regulations governing the construction and use of Particular
Sewers, as now or at any future time established by the Board of Selectmen.

Am't of estimate \$.....

Am't Paid \$.....

..... Owner

Sketch of Service Here

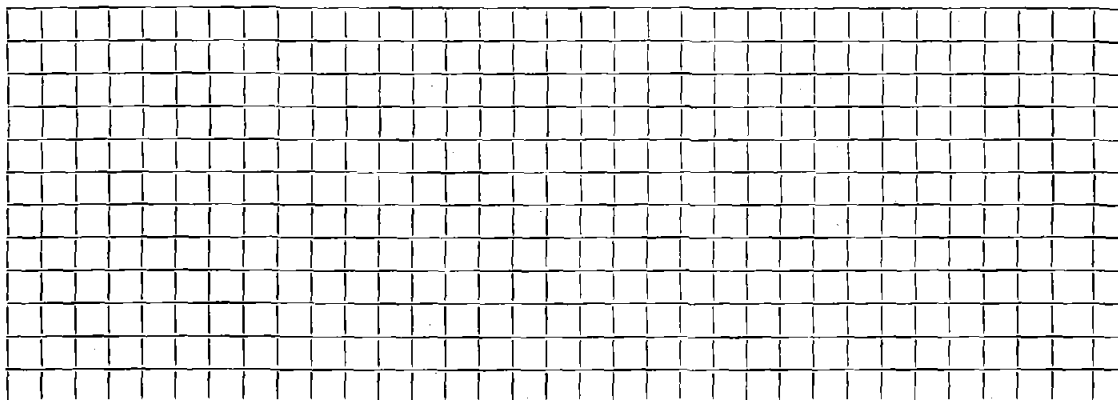

Connection made in..... Street.

Work completed.....19..

Remarks: