


DATE _____

TOWN OF LEXINGTON — BOARD OF PUBLIC WORKS
SEWER DIVISION

Sketch of Service Here

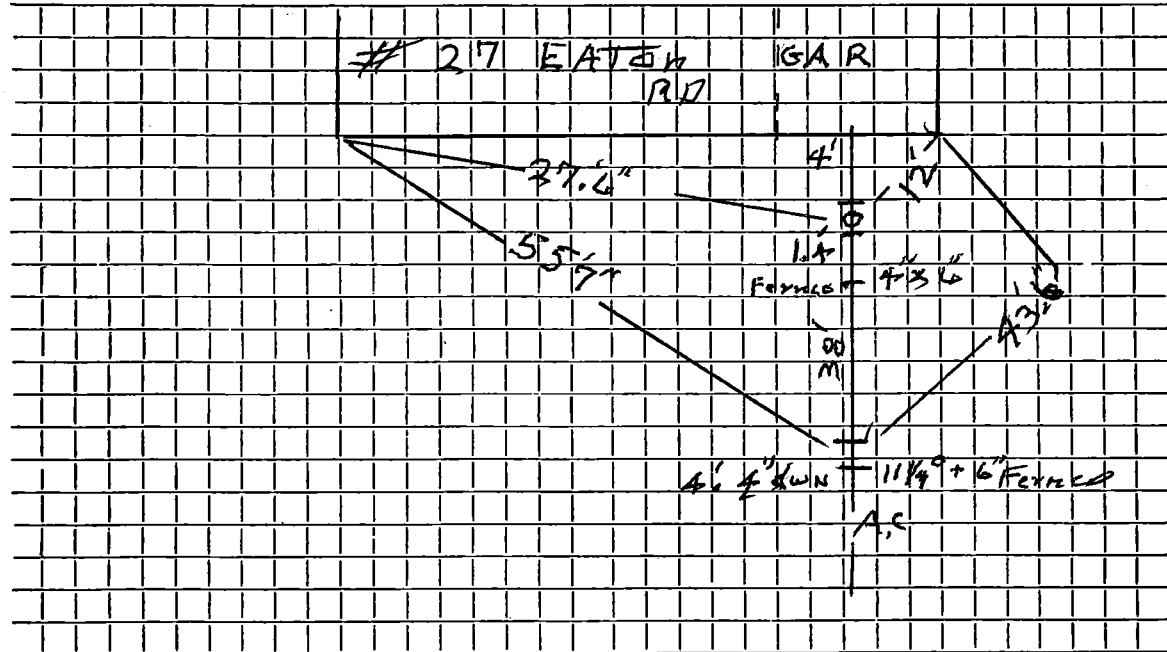

Connection made in Street. Work completed .. 9/19/12 J. Keeling

Remarks: WATER LINE CROSSES SEWER 5' IN FRONT OF CURB BOX

.....
.....