

Name **Telfer Const. Co.**

Service No. **63**

Address **31 Eaton Rd.**

**Lexington, Mass.**

Location

Kind of Pipe

Size

Size of Main

~~Repair~~ ~~Renewal~~ **New Service**

*com. 7-24-51*

Location

Date	Material	Amount	Total	Date	Amount
8/11/51	Labor	48 81	48 81	July 12 51	Deposited 150 00
	10% overhead		4 88		
	76' 6" sewer pipe @ .342		25 99		
	joint compound		4 56		
	6 hrs. Littlefield shovel		42 00		
	2 hrs. trucking		1 50		
			127 74		
	Labor				

TOWN OF LEXINGTON—DEPT. OF PUBLIC WORKS  
**SEWER DIVISION**

DATE .....

NO. ....


The undersigned applies for the construction of a particular sewer connecting No. ....  
Street and hereby agrees to comply with the Rules and Regulations governing the construction **and** use of Particular  
Sewers, as now or at any future time established by the Board of Selectmen.

Am't of estimate \$.....

Am't Paid \$.....

..... Owner

**Sketch of Service Here**

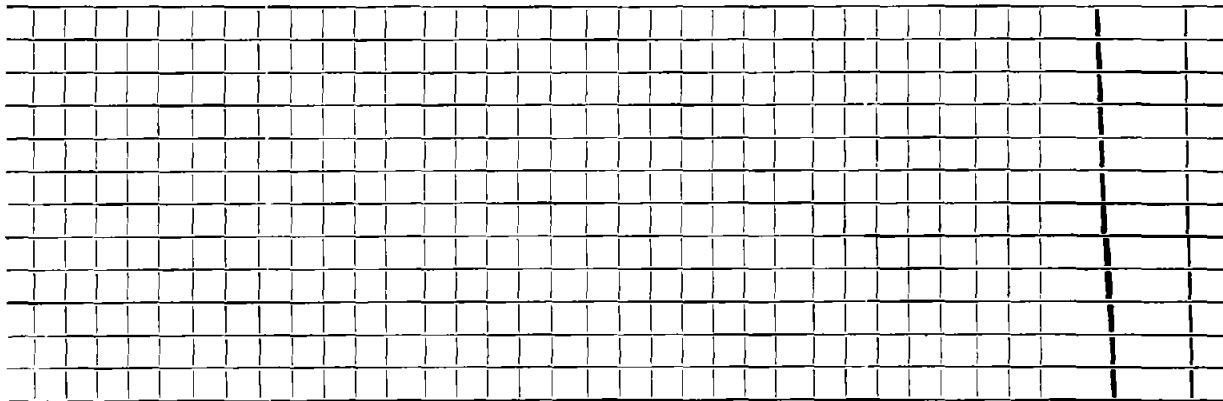

Connection made in ..... Street.

Work completed .. - - - - - 19..

Remarks: