

Name

Michael Sprague (Insp.)

Service No.

Address

17 Edgewood

Location

Kind of Pipe

SDR 35 PVC

Size

6"

Size of Main

Repair—Renewal—New Service

Location

Date

Material

Amount

Total

Date

Amount

8/24/18

45° Bend

SDR 35 PVC

cleanout

SDR 35 PVC


Fernco

Depth = 3.5'

DATE 8/24/18

TOWN OF LEXINGTON — BOARD OF PUBLIC WORKS
SEWER DIVISION

Sketch of Service Here

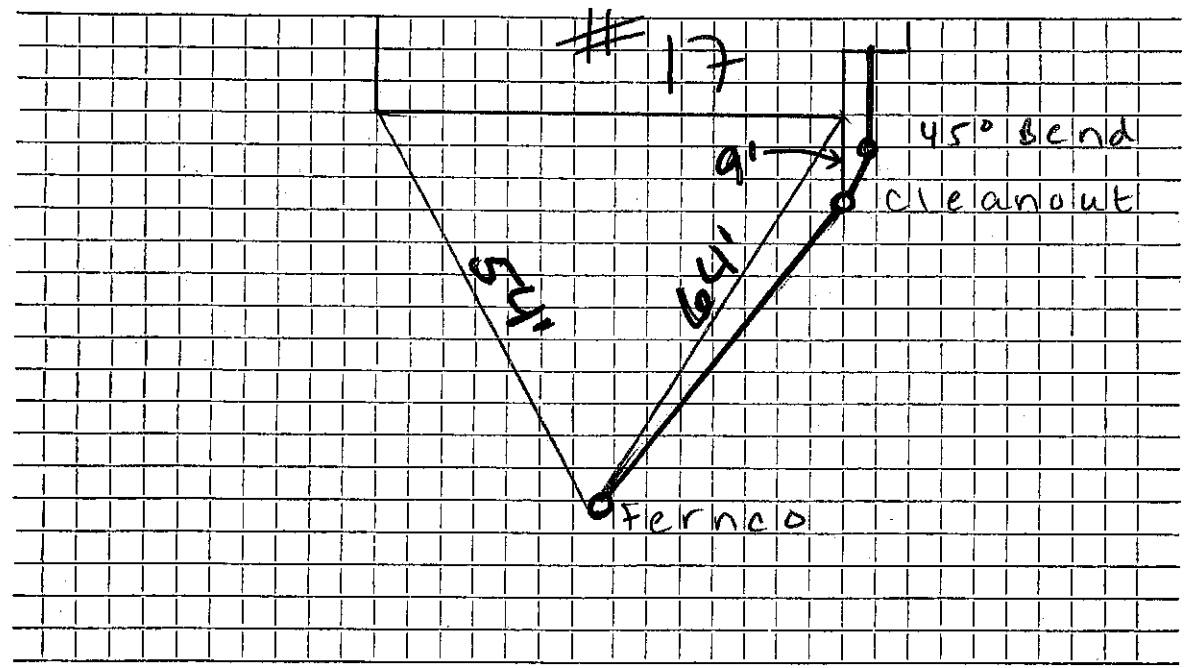

Connection made in ... Edgewood ... Street. Work completed

Remarks:
.....
.....