




DATE 3/26/96.

TOWN OF LEXINGTON — BOARD OF PUBLIC WORKS  
SEWER DIVISION

23 EDGWOOD RD  
PERMIT 749.  
SAW BOOK 96-1

Sketch of Service Here **23**

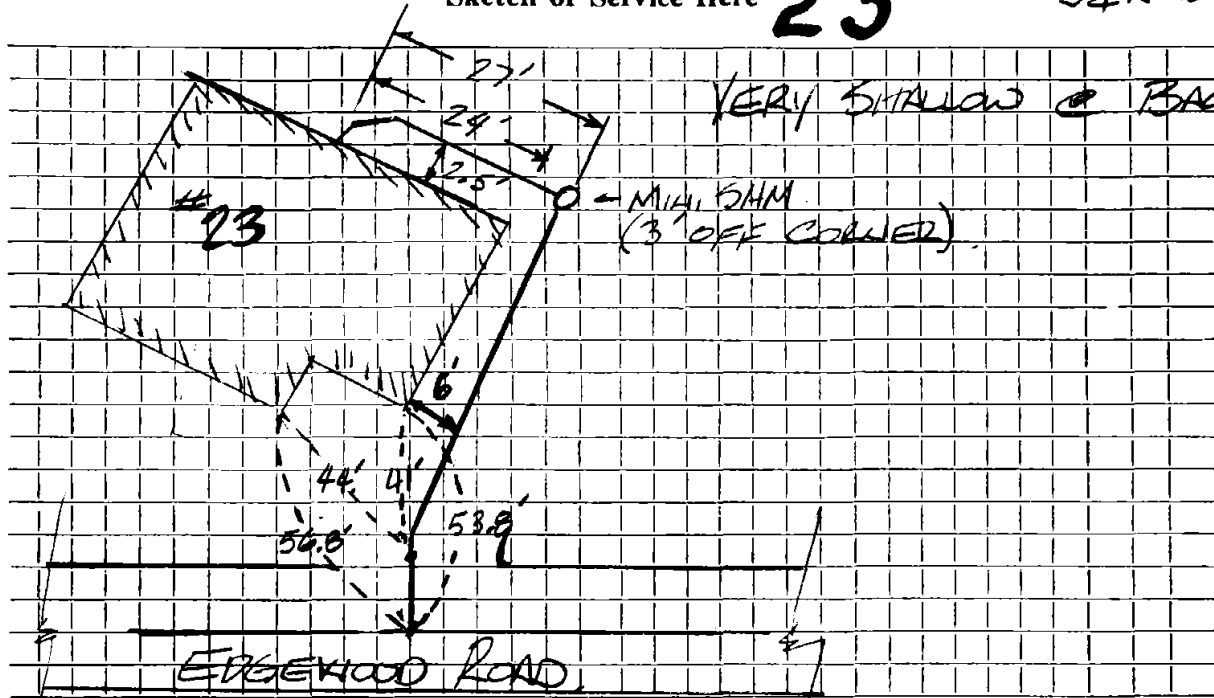

Connection made in 23. EDGWOOD RD. Street. Work completed .....

Remarks: .....  
J. McLAUGHLIN.  
MIN. PITCH - 5.5 deep @ ROAD. 2' deep @ BACK OF HOUSE.