


DATE AUGUST 2001

TOWN OF LEXINGTON — BOARD OF PUBLIC WORKS

SEWER DIVISION

Sketch of Service Here

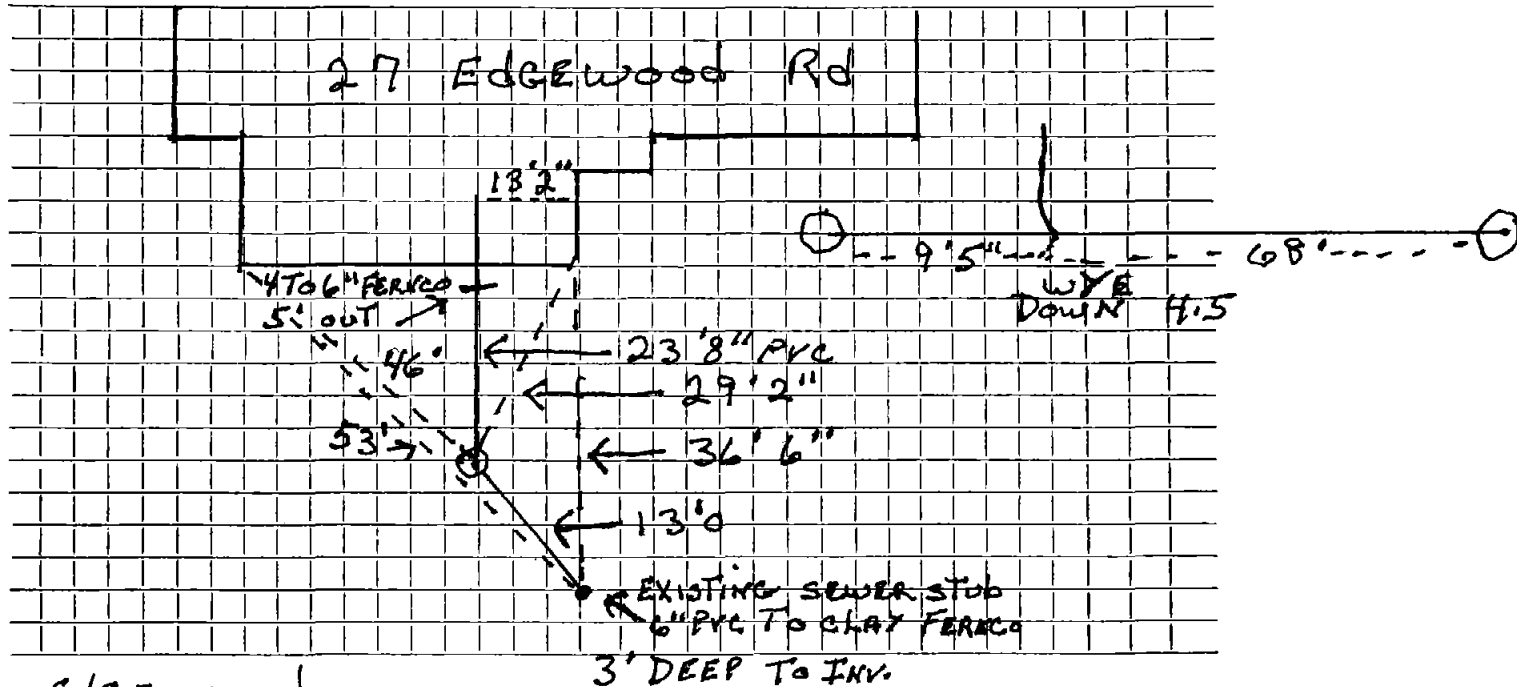

Connection made in EDGEWOOD Street. Work completed

Remarks: INSTALLED BY J.M. McLAUGHLIN