


DATE _____

TOWN OF LEXINGTON — BOARD OF PUBLIC WORKS

SEWER DIVISION

Sketch of Service Here

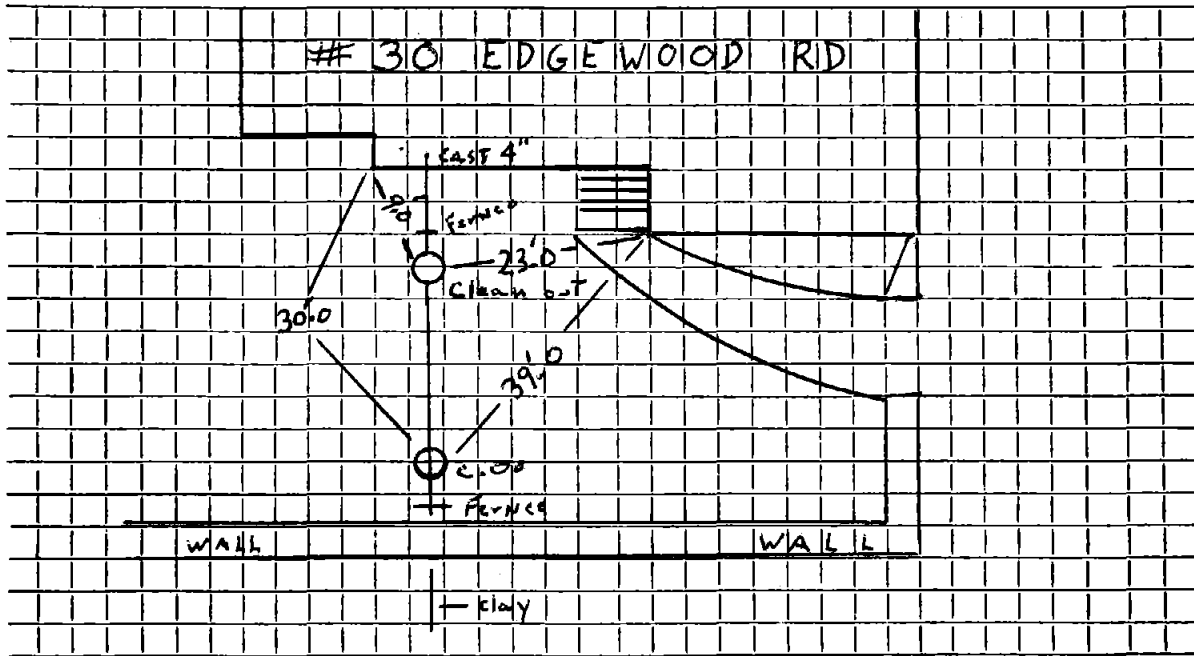

Connection made in Street.

Work completed 9/06 Arlex oil.....

Remarks:

.....

.....

TOWN OF LEXINGTON—BOARD OF PUBLIC WORKS

SEWER DIVISION

DATE March 30, 1938.

NO. _____


The undersigned applies for the construction of a particular sewer connecting No. 30 Edgewood Road Street and hereby agrees to comply with the Rules and Regulations governing the construction and use of Particular Sewers, as now or at any future time established by the Board of Selectmen.

Am't. of Estimate \$ _____

Am't. Paid \$ _____

Charles R. Metcher, Jr. Owner

Sketch of Service Here

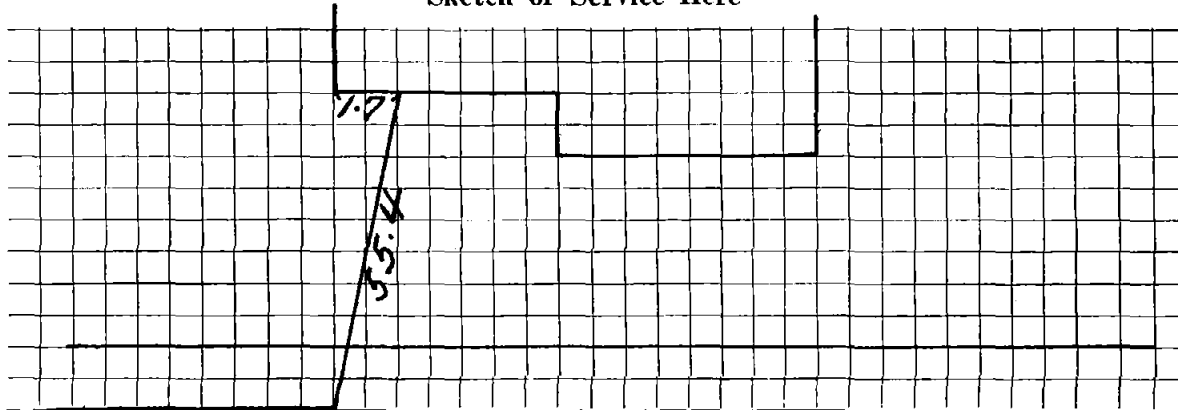

Connection made in _____ Street.

Work completed _____ 19

Remarks: