

Name R. Charles Ofria

Service No. 93

Address ~~45 IVAN STREET~~

15 Eldred

Location Lot #134

Kind of Pipe

Size

Size of Main

Repair—Renewal—New Service

Location Comm 12-8-58

Date	Material	Amount	Total	Date	Amount
	25' 6" V.C. @ 3.00	75.00		5-26-58	150.00
	Installed by contractor			12-8-58	20.84
	(Bill to owner when connected)	75.00		3-7-62	25.13
					194.27
6/23/58	Labor	20.40			
6/24/58	"	37.03			
		57.43			
	10% overhead	5.74	63.17		
	40' - 6" Transite pipe @ .70		28.00		
	1 1 1/4° Transite Bend		5.10		
	3 ton 1 1/4" Stone @ 6.50T		4.50		
	2 hrs. Town Shovel @ 6.50		13.00		
	2 hrs. Labor trucking @ .75		1.50		
	1 hr. Rodgers Trailer		3.00		
	1 hr. Trucking		3.00		
			196.27		

TOWN OF LEXINGTON—DEPT. OF PUBLIC WORKS
SEWER DIVISION

DATE.....

NO.


The undersigned applies for the construction of a particular sewer connecting No.....
Street and hereby agrees to comply with the Rules and Regulations governing the construction and use of Particular
Sewers, as now or at any future time established by the Board of Selectmen.

Am't of estimate \$.....

Am't Paid \$.....

..... Owner

Sketch of Service Here

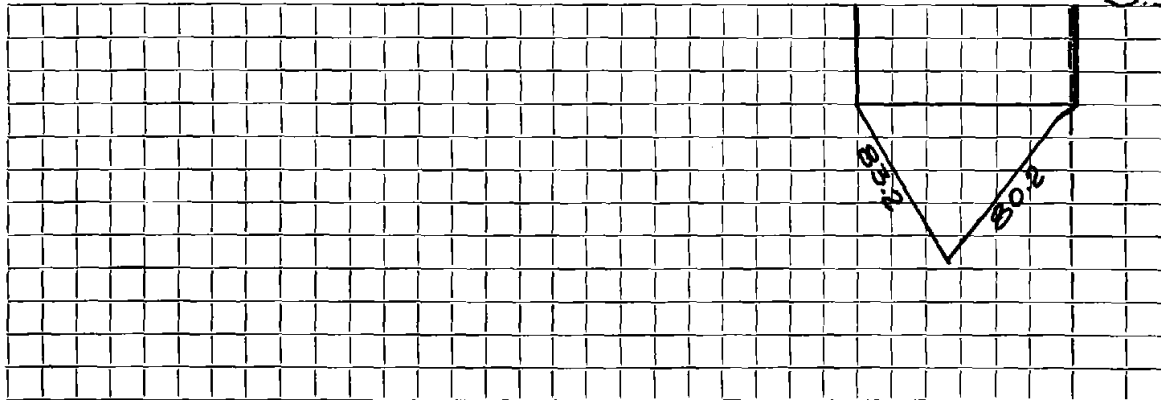

S.S. For # 45- Lot # 134

Connection made in..... Street.

Work completed..... 19..

Remarks: