





Name William H. Sullivan

Service No. 158 (1954)

Address 18 Eldred Street

Location

Kind of Pipe

Size

Size of Main

~~Repair~~ ~~Renewal~~ ~~Repair~~ ~~Renewal~~ - New Service

COM. 3-21-55

Location

Date	Material	Amount	Total	Date	Amount
1/24/55	Labor	21 05		11-12-54	125 00
1/25/55	"	57 63		3-21-55	36
1/26/55	"	44 33	123 00		
	10% overhead		12 30	4-14-55	95 77
	64' - 6" sewer pipe @ .32		20 48		221 13
	joint compound		3 84		
	8 hrs. Littlefield shovel @ 7.50		60 00		
	2 hrs. trucking @ .75		1 50		
			221 13		
	<b>Labor</b>				
				12/11/55	3-21-

**TOWN OF LEXINGTON—DEPT. OF PUBLIC WORKS**  
**SEWER DIVISION**

DATE.....

NO. ....


The undersigned applies for the construction of a particular sewer connecting No.....  
Street and hereby agrees to comply with the Rules and Regulations governing the construction and use of Particular  
Sewers, as now or at any future time established by the Board of Selectmen.

Am't of estimate \$.....

Am't Paid \$.....

..... Owner

**Sketch of Service Here**

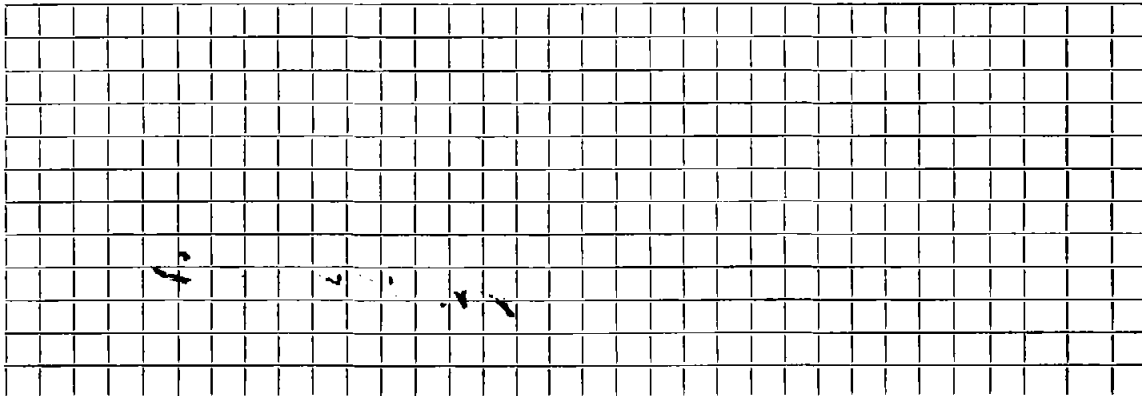

Connection made in..... Street.

Work completed.....19..

Remarks: