

Name William H. Sullivan

Service No. 56

Address 19 Eldred Street

Location

Kind of Pipe

Size

Size of Main

~~Repair-Renewal~~ - New Service

Com. 6-1-54

Location

Date	Material	Amount	Total	Date	Amount
4/22/54	Labor	53 93		4-15-54	Deposited 125 00
	10% Overhead	5 39	59 32	6-1-54	Paid 9/c 3 16
	52' 6" Sewer Pipe @ .3087		16 05	6-11-54	Paid 6 21
	1 - 6" Elbow		1 88		134 37
	Joint Compound		3 12		
	7 hrs. Ltfl'd. Shovel @ 7.50		52 50		
	2 hrs. trucking		1 50		
			134 37		
	Labor				

**TOWN OF LEXINGTON—DEPT. OF PUBLIC WORKS
SEWER DIVISION**

DATE.....

NO.


The undersigned applies for the construction of a particular sewer connecting No.....
Street and hereby agrees to comply with the Rules and Regulations governing the construction and use of Particular
Sewers, as now or at any future time established by the Board of Selectmen.

Am't of estimate \$.....

Am't Paid \$.....

..... Owner

Sketch of Service Here

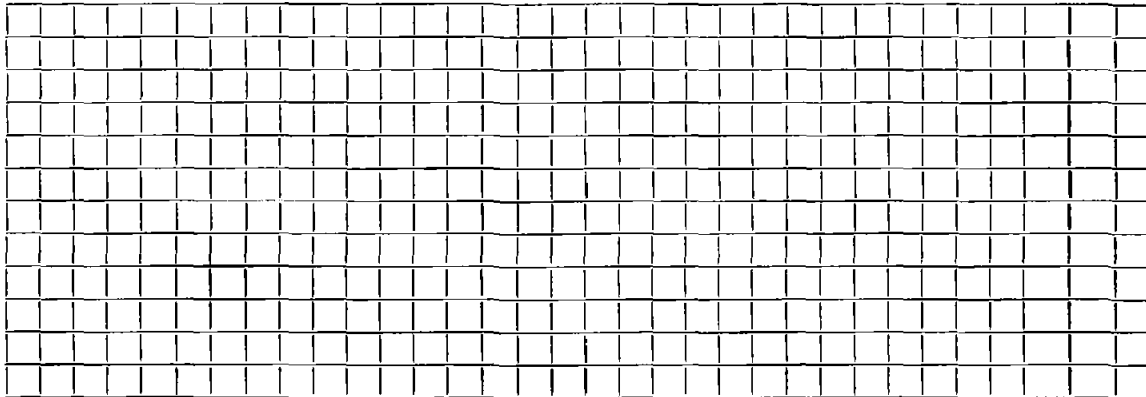

Connection made in..... Street.

Work completed.....19..

Remarks: