

Name Maria L. Rodrigues

Service No. 82

Address 24 ELDRED STREET

Location Lot 115A

Kind of Pipe

Size

Size of Main

~~Repair~~ ~~Renewal~~ ~~Work~~ **New Service** Russell Sibley Permit #349

Location AUG 9 1965

| Date | Material | Amount | Total | Date | Amount |
|--------|---|--------|-------|---------|---------------|
| | 25' 6" V.C. @ 3.00 Installed by contractor (Bill to owner when connected) | 75 00 | | 6-22-65 | Deposit 75 00 |
| 7-1-65 | 36' 6" Transite pipe | | | | |
| | Labor | | | | |

TOWN OF LEXINGTON—DEPT. OF PUBLIC WORKS

SEWER DIVISION

DATE.....

NO.


The undersigned applies for the construction of a particular sewer connecting No.....
 Street and hereby agrees to comply with the Rules and Regulations governing the construction and use of Particular
 Sewers, as now or at any future time established by the Board of Selectmen.

Am't of estimate \$.....

Am't Paid \$.....

..... Owner

Sketch of Service Here

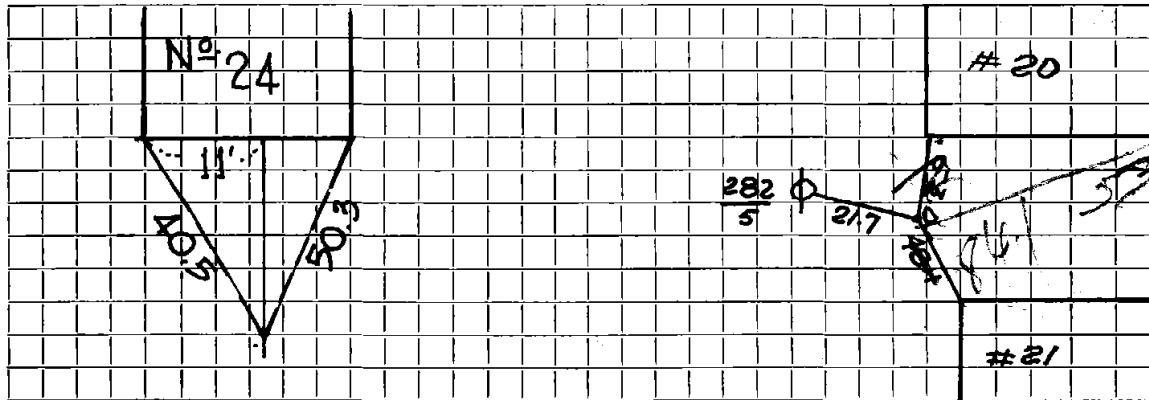

S.S. For # 24
 Lot # 115 A

Connection made in..... Street.

Work completed.....19..

Remarks: