



DATE 6/8/2023

TOWN OF LEXINGTON — BOARD OF PUBLIC WORKS  
SEWER DIVISION


Sketch of Service Here

Tie to cleanout

47'-8" = A  
48'-0" = B

Tie to clay  
connection  
in street

62'-2" = A  
62'-8" = B

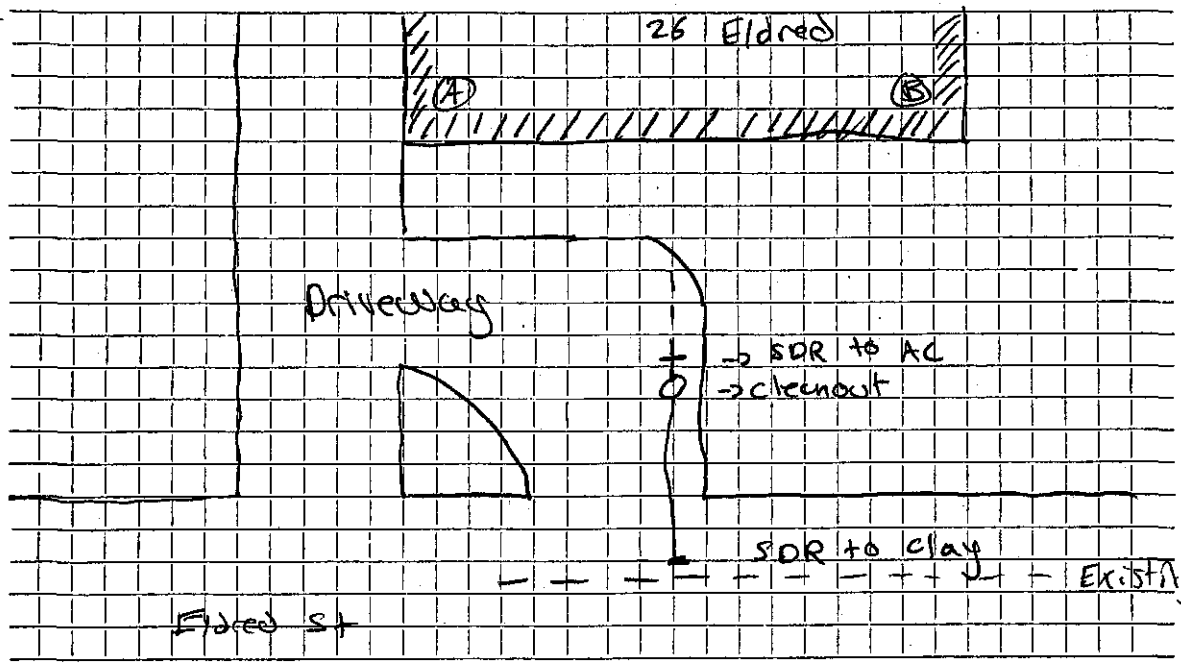

SDR/clay to  
cleanout = 16'

cleanout  
assembly = 1'

cleanout to  
SDR/AC = 7'

Connection made in Eldred St Street. Work completed .....

Remarks: Wright - Pierce .....